


Section 30 Township 19 Range 13 W

Well No. # 1 Warner

Company G-M-R Oil

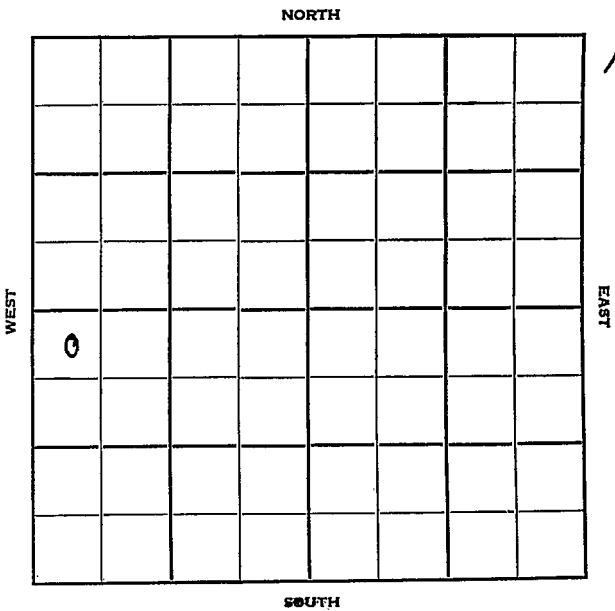

Barton

KANSAS

Sec. 30 Twp. 19 R. 13W

Well No. #1 Warner Farm

G-M-R Oil Company

Contractor


SW Great Bend Pool

330' Ft. from N. Line

..... Ft. from S. Line

..... Ft. from E. Line

330' Ft. from W. Line

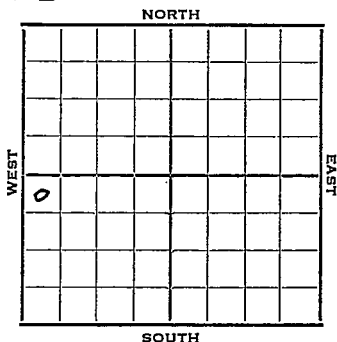

NW NW SW

1952 Elev. 1865' REPORT

3/19 Anhy 770
8" @ 782
Drlg. 1865'

3/25 Heeb 3088' Br. Li 3185' Lans. 3198'
DST 3200-3208' failed.
DST 3202-26, 1 hr, 30' 0 & GCM
Drlg. 3250'

4/1 DST 3314-28, 1/2 hr, 60' 0 & GCM, 840#
DST 3338-46, 45 mins, 120' SO & GCM
840# Cong. 3452' Arb. 3483'
TD 3489' 4" @ 3485'

4/9 DP DD to 3508 TD 6 BWPB PB 3450
42/3320-44 2000 A PB 3370
24/3336-44 900 A 18/3320-26 1100 A
S/38 BO 1st 45 mins S/26 BO 1/2 hr.
Set plug 3215 21/3202-09
2000 A S/2 BO 1st hr.
S/1 BOPH for 3 hrs. DP 3370
S/35 BO 1/2 hr. POP

4/23 NR
4/30 "
5/7 "
5/13 Spud 3-13-52 Oil Well TD 3508
Anhy 770' 8" @ 782' Heeb. 3088
Br Li 3185' Lans. 3198
DST 3200-3208 failed

OVER

1952

5/14

~~Spdx 34352~~
~~Oil Well TD 3508'~~

~~Any of~~

DST 3202-26 open 1 hr. rec. 30'

O&GCM DST 3314-28 open $\frac{1}{2}$ hr. rec.

60' O&GCM DST 3338-46 open 45 min.

Rec. 120' SO&GCM Cong. 3452'

Arb. 3483 TD 3489 4" @ 3485

DD 3508 6 bwph PB 3450 42/ 3320-44

2000 A PB 3370 24/ 3336-44 900 A

18/ 3320-26 1100 A S/ 38 bo 45 min.

S/ 26 bo $\frac{1}{2}$ hr. SP 3215 21/ 3202-09

2000 A S/ 2 boph DP 3370 S/ 35 bo

$\frac{1}{2}$ hr. DP to 3370' S/ 35 bo $\frac{1}{2}$ hr.

Comp. 111 bopd 26% wtr.

COMPLETED

