KANSAS

FORM 51 5M 1-42 PETROL


Russell

Section 10 Township 15 Range 15-W

Well No. #2 Devovan "C"

Company Wolf Creek

Devonan Pool

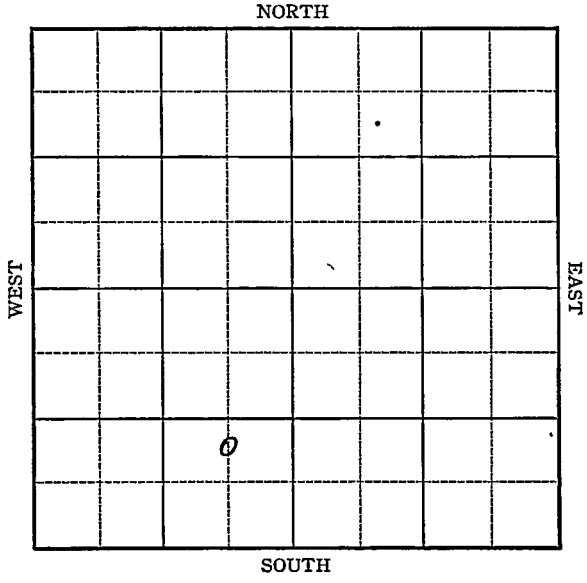

FORM 252-A
5M 10-41 PETROL

KANSAS

Russell

Sec 10 Twp. 15 R. 15-W

Well No. #2 Donovan "C" Farm

Wolf Creek Company


(Donovan)

____ Ft. from N. Line

990 Ft. from S. Line

660 Ft. from E. Line

____ Ft. from W. Line

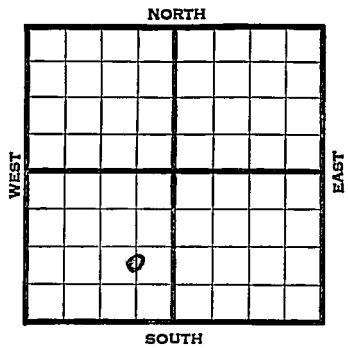

Elev. 1798

1942	REPORT
2/25	Cable rig.
3/5	Drlg. 410'
3/12	Drlg. 1110'
3/19	Drlg. 1600'
3/26	15" - 205' 12" - 550' Anhy 851'
	10" - 858' 8" - 2495'
	Drlg. 2510'
4/2	8" - 2519' Topeka 2693'
	Drlg. 2850'
4/8	Lans. 3039' 7" - 3039'
	3170' U.R. 7".
4/15	Cong. 3270'
	Arb. 3305'
	T.D. 3322'
	Water.
	ABANDONED

Form 26 200 Bks. 5-41 McW. Russell KANSAS

Map No. 73 Sec. 10 Twp. 15 R. 15W

Well No. 2 Donovan "C"

Wolf Creek Company

FIRST REPORT Contractor

C NL SE SW


____ Ft. from N. Line

990 Ft. from S. Line

660 Ft. from E. Line

____ Ft. from W. Line

SECTION PLAT

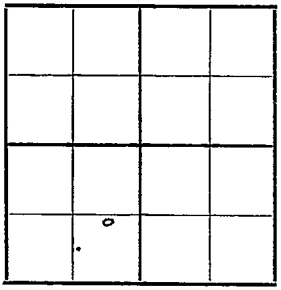

DONOVAN POOL

Location

Rig up

Drilling and Remarks:

Cable Rig

RECORD

Cased ____ in., ____ ft.

Sand

Gas

Oil

Total Depth

PRODUCTION

1st 24 hrs. Nat.

1st 24 hrs. after shot

Gas ____ Cu. Ft.

Dry Hole

Abandoned

Date

FEB 2 5 1942

19 S. J. LEWIS Scout

Form 26 200 Bks. 5-41 McW. Russell KANSAS

Map No. 23 Sec. 10 Twp. 15 R. 15W

Well No. 2 Donovan "C"

Wolf Creek Company

ABANDONED Contractor

C NL SE SW


____ Ft. from N. Line

990 Ft. from S. Line

660 Ft. from E. Line

____ Ft. from W. Line

SECTION PLAT

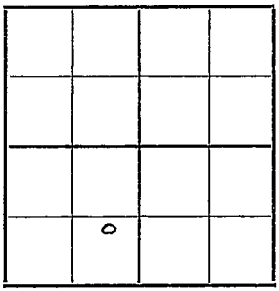

DONOVAN POOL

Location

Rig up

Drilling and Remarks:

Comp 8270
GR 3305.
Water

RECORD

Cased ____ in., ____ ft.

Sand

Gas

Oil

Total Depth 8322

PRODUCTION

1st 24 hrs. Nat.

1st 24 hrs. after shot

Gas ____ Cu. Ft.

Dry Hole

Abandoned

Date

APR 15 1942 19 S. J. LEWIS Scout