


Section 29 Township 13 Range 14 W

Well No. # 5 Miller "B"

Company D. R. Lauck Oil

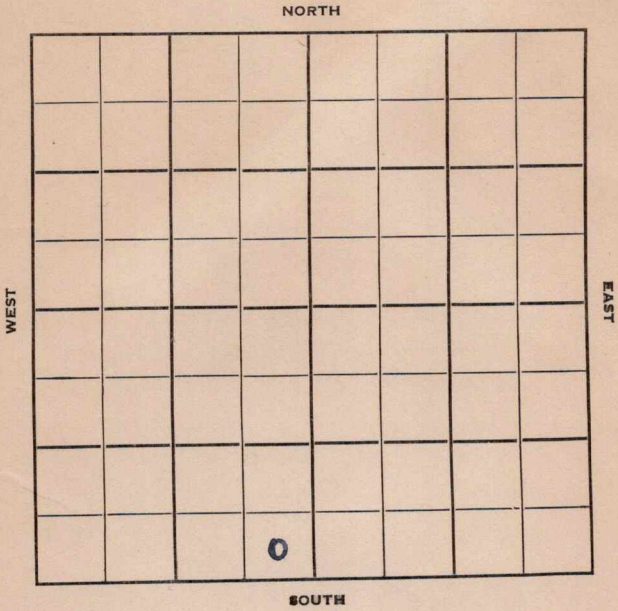

Russell

KANSAS

Sec. 29 Twp. 13 R. 14W

Well No. #5 Miller "B" Farm

D. R. Lauck Oil Company

Lauck Contractor
Atherton Pool


 Ft. from N. Line

330 Ft. from S. Line

330 Ft. from E. Line

 Ft. from W. Line

SE SE SW

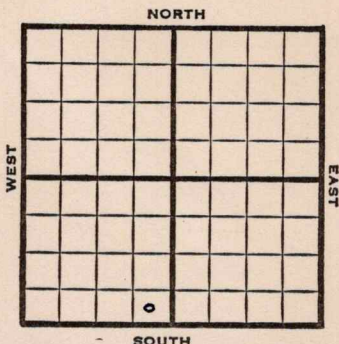

1952

Elv. 1875'

REPORT

- 10/1 MIR
 - 10/8 8" @ 190'
Drlg. 2792'
 - 10/15 Heeb 2992, Lans 3042, Arb 3312-13 RTD
5" @ 3313'
 - 10/22 DD 3321' TD fill up oil
 - 10/29 NR
 - 11/5 "
 - 11/12 Spud 9-30-52 Oil well TD 3321'
8" @ 190 Anhy 920' Heeb 2992'
Lans. 3042' Arb. 3312' 5" @ 3313'
TD 3321'
Comp. 40 BOPD
- COMPLETED**

