

Russell

KANSAS

Sec. 29 Twp. 13 R. 11W

Well No. #2 National Bank of Topeka Farm

Jess Hummell Company

Stearns Contractor


990 Ft. from N. Line

Ft. from S. Line

Ft. from E. Line

330 Ft. from W. Line

SW NW SW

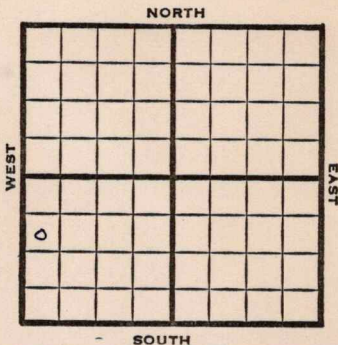

1952 **Elev. 1872'** REPORT

3/26 Spud 3-21-52
8" @ 209'
Anhy 925
Drlg. 955'

4/1 **Topeka 2705 Heeb. 2992**
Lans. KC 3042
Drlg. 3155'

4/9 **Arb. 3308-09 RTD**
5" @ 3308 DP DD 3310 TD 200 A

4/23 NR

4/30 POP

5/7 NR

5/14 "

5/21 "

5/28 "

6/4 Spud 3-21-52

Oil Well TD 3310

8" @ 209 **Anhy 925**

Top. 2705 Heeb. 2992

Lans. 3042 Arb. 3308

5" @ 3308 TD 3310 200 A

Comp. 50 bopd 10% wtr.

COMPLETED

