

Russell

KANSAS


Form 51—5M—11-38—Palace

Section 30 Township 13 Range 14-W

Well No. #1 Atherton

Company Phillips

NORTH Atherton Pool

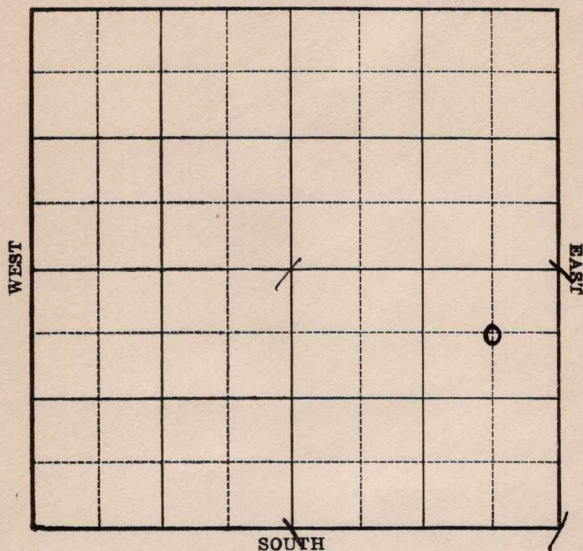

KANSAS


Russell

Sec. 30 Twp. 13 R. 14 -WWell No. #1 Atherton FarmPhillips Company

(Atherton)

660 Ft. from N. Line Ft. from S. Line660 Ft. from E. Line Ft. from W. Line

Elev. 1886'

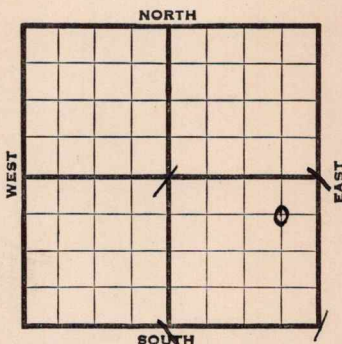

1939	REPORT
3/15	Location
3/24	B.R.R.
3/31	R. R.
4/7	9" - 513' Anhy 900'
	Drlg. 2805'
4/14	Lans. 3048' S.O. 3048-51'
	Arb. 3316-17' T.D. No shows.
	5" - 3316' RUST.
4/21	" " "
4/28	T.D. 3323' 2500' oil 8 hrs.
	Swab 87 oil in 8½ hrs.
5/5	" " " "
	" " " "
5/10	Arb. 3316'
	5" - 3316'
	T.D. 3323'
	Echometer potential 834 bbls.
	natural.
	COMPLETED

Russell

KANSAS

Map No. 72 Sec. 30 Twp. 13 R. 14WWell No. 1 Atherton


Phillips

Company

Contractor

FIRST REPORT

SECTION PLAT

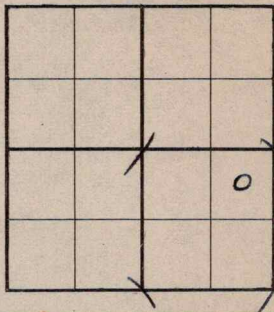

C NE SE

660 Ft. from N. Line Ft. from S. Line660 Ft. from E. Line Ft. from W. Line

ATHERTON POOL

Location XRig up

Drilling and Remarks:

RECORD

Cased in., ft.Sand Gas Oil Total Depth

PRODUCTION

1st 24 hrs. Nat. 1st 24 hrs. after shot Gas Cu. Ft.Dry Hole Abandoned

Date

MAR 15 1939

19

H. D. Hatfield

Scout

Russell

KANSAS

Map No. _____ Sec. 30 Twp. 13 R. 14WWell No. 1 AthertonPhillips

Company

Contractor

COMPLETED

SECTION PLAT

			0

C NE SE

660 Ft. from N. Line

_____ Ft. from S. Line

660 Ft. from E. Line

_____ Ft. from W. Line

ATHERTON POOL

Location _____

Rig up _____

Drilling and Remarks:

*Cur. 3316**5' @ 3316**Echometer Pot.**834 Nat.*

RECORD

Cased _____ in., _____ ft.

Sand _____

Gas _____

Oil _____

Total Depth 3323

PRODUCTION

1st 24 hrs. Nat. _____

1st 24 hrs. after shot _____

Gas _____ Cu. Ft.

Dry Hole _____

Abandoned _____

Date

MAY 10 1939 19

S. J. LEWIS

Scout