
Russell KANSAS

SECTION 30 TOWNSHIP 13 RANGE 14W

WELL NO. #3 Atherton

COMPANY Kim Oil

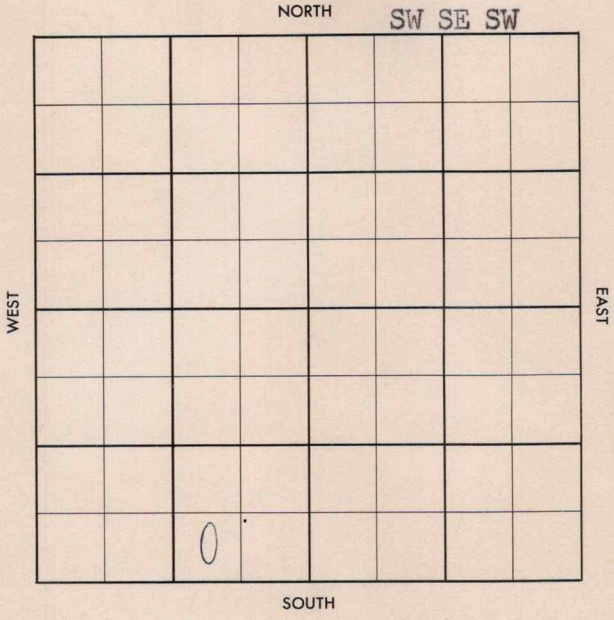

FORM 504-3 SUNRAY

FORM 513 SUNRAY

Co.

County Russell Elev.

Sec. 30 Twp. 13 Rge. 14W

Company Kim Oil

Farm Name Atherton No. 3

TOPS	DEPTH	LOG	DATUM
Anh.	912		
Tp.			
H.			
Tr.			
Dg.			
B.L.			
L.			
K.C.			
B.K.C.			
Ce.			
C.			
M.			
M.			
K.			
Mz.			
Mq.			
V.			
S.			
S.			
A			
R.			
P€.			
G.			
T.D.			

Loc. in Sec. SW SE SW

Geol.

Contr.

Lse.

Pool Russell

FIRST REPORT

MAY 22 57

0

Date Comm. 5-15-57

8" @ 577/150 drlg. 2040

FORM 513 SUNRAY

County Russell Elev. 1876

Sec. 30 Twp. 13 Rge. 14W

Company Kim Oil

Farm Name Atherton No. 3

TOPS	DEPTH	LOG	DATUM
Anh.	912		
Tp.	2361		
H.	2983		
Tr.			
Dg.			
B.L.			
L.	3033		
K.C.			
B.K.C.			
Ce.			
C.			
M.			
M.			
K.			
Mz.			
Mo.			
V.			
S.			
S.			
A	3302		
R.			
P€.			
G.			
T.D.	3305		

Loc. in Sec. SW SE SW

Geol.

Contr.

Pool Russell

COMPLETE

JUN 5 '57

Date Comm. 5-15-57

8" @ 577/150 drlg. 2040 MAY 29 '57

5½ 3304/125 JUN 5 '57 CO 3305

TP 1½ Hole Full oil & gas

est 8. 25 Bopd no wtr.