

Russell KANSAS

Section 30 Township 13 Range 14W


Well No. 6 Boxberger *Atherton*
(East)

Company Kim Oil

NORTH

WEST

EAST

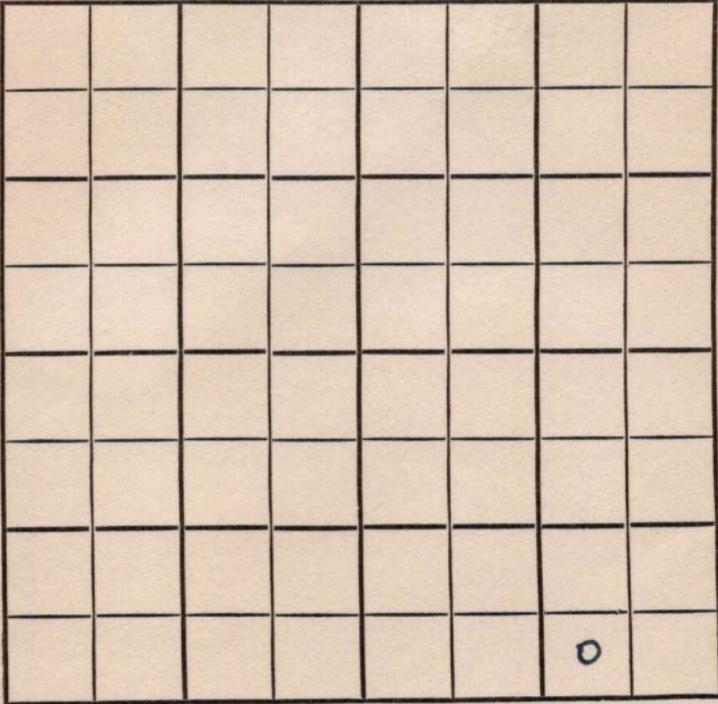

SOUTH

Russell KANSAS

SEC.	TWP.	R.
30	13	11W
WELL NO. ATHERTON		FARM
6 Berberger (East)		
COMPANY		

Kim Oil

CONTRACTOR

Sidey


Atherton Pool

_____ Ft. from N. Line

330 _____ Ft. from S. Line

990 _____ Ft. from E. Line

_____ Ft. from W. Line

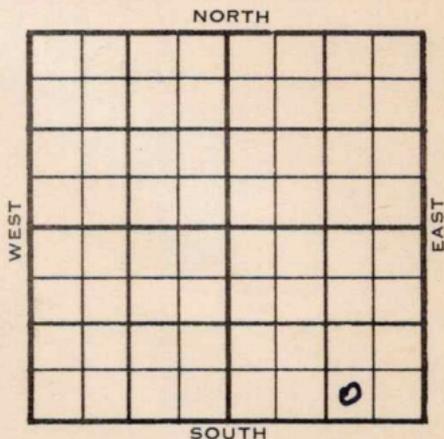

SW SE SE

	ELEVATION	REPORT
1954	1876'	

7/21 Spdg 7-17-54
8" @ 204
Drlg. 2120

8/4 Spud 7-17-54 - Oil Well
TD 3322'
8" @ 204'
**Top 2767', Heeb 2993', Lans 3043',
Arb. 3317'**
TD 3319'
5" @ 3319'
DD 3322'
FU 500' oil 500A
FU 1500' oil
Comp. 25 bopd

COMPLETED

Kansas

Map No. _____ Sec. 30 Twp. 13 R. 14W

Well No. 6 Atherton

Kim Oil Company

CORRECTION

Contractor

SW SE SE

SECTION PLAT

_____ Ft. from N. Line

330 Ft. from S. Line

990 Ft. from E. Line

_____ Ft. from W. Line

			0

Russell County

Location _____

Rig up _____

Drilling and Remarks:

Reported
#6 Boxberger

RECORD

Cased _____ in., _____ ft.

Sand _____

Gas _____

Oil _____

Total Depth _____

PRODUCTION

1st 24 hrs. Nat. _____

1st 24 hrs. after shot _____

Gas _____ Cu. Ft.

Dry Hole _____

Abandoned _____

Date

AUG 4 1954

J. G. McGEHEE

Scout

