


DX 78-1, Russell

KANSAS

Section 30 Township 13 Range 14W

Well No. #7 Atherton (East)

Company Kim Oil

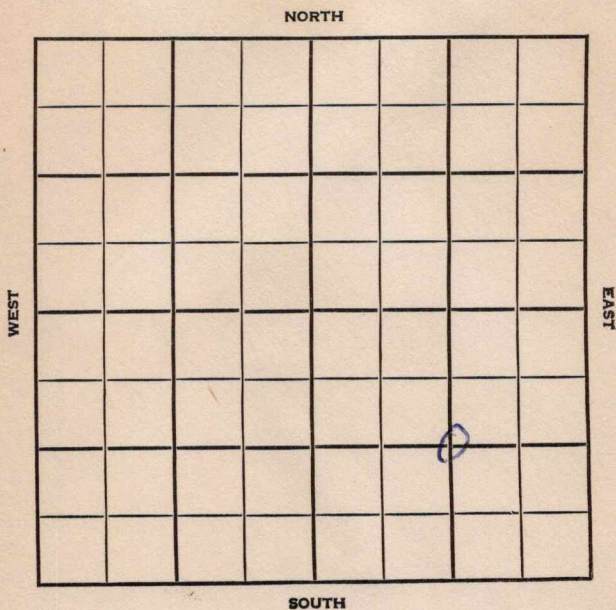

Russell

KANSAS

SEC.	TWP.	R.
30	13	14 W
WELL NO.		
# 7 Atherton (East)		
COMPANY		FARM
Kim Oil		
CONTRACTOR		


_____ Ft. from N. Line

_____ Ft. from S. Line

_____ Ft. from E. Line

_____ Ft. from W. Line

C SE/4

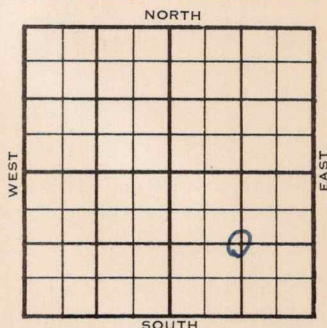

1955

ELEVATION

1883'

REPORT

6/22

Comm. 5-6-55

8" @ 200

DST 2946-60, open 40 min rec 15' mud 850#

DST 3053-94 open 1 hr rec 185' MW

770# 5 1/2" @ 3314

12/2958-62 SSW PB 2841

6/2784-86 12/2776-79 6/2768-70

1000 A 2 gal. dead oil 2 BW 12 hr.

CO to 3314 FU 1600' fluid CO to 3314

1 1/2 BO 1/2 BW 2 hr. 1000 A 4 BOPH

8 hr. Comp. 25 BOPD

Anhy 920', Tp 2763', H 2792',

L. 3043', Marm. 3218', A. 3312'

TD 3314'

FIRST REPORT

COMPLETED

CountyRussellElev.1883

Sec.30Twp.13Rge.14W

CompanyKim Oil

FarmNameAthertonNo.7

TOPS	DEPTH	LOG	DATUM	Loc. in Sec.
Anh.	920			C SE/4
Tp.	2763		880	
H.	2992		1109	
Tr.				
Dg.				
B.L.				
L.	3043		1160	Geol.
K.C.				Contr.
B.K.C.				
Ce.				
C.				
M. arm	3248		1365	Pool
M.				
K.				
Mz.				
Ma.				
V.				
S.				
S.				
A	3312		1429	
R.				
Pe.				
G.				
Ed.	3314			

FIRST REPORT
COMPLETE

Date Comm.5-6-55JUN 22 1955

8" @ 200DST 2946-60open 40 min.

Rec. 15' mud850#DST 3053-94

open 1 hr. Rec. 185' mw770#

5 1/2" @ 331412/ 2958-62SSWPB 2841

6/ 2784-8612/ 2776-796/ 2768-70

1000 A2 gal. dead oil2 bw12 hr.

CO to 3314FU 1600' fluidCO to 3316

1 1/2 bo 1 1/2 bw2 hr.1000 A4 boph8 hr

Comp. 25 bopd