


Russell

KANSAS

Section 30 Township 13 Range 14W
Well No. #4 Atherton (East)
Company Spurgeon et al

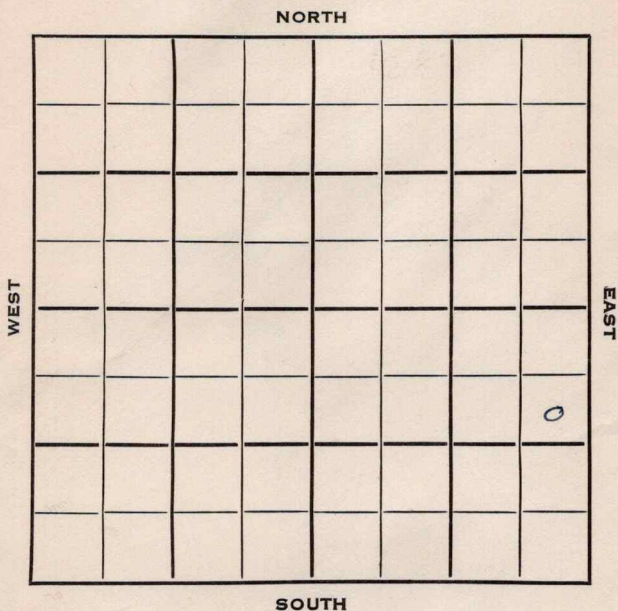

Russell KANSAS ✓


Sec. 30 Twp. 13 R. 14 WWell No. # 4 Atherton (East) FarmSpurgeon et al CompanyStearns Drlg. Contractor990 Ft. from N. Line

Ft. from S. Line

330 Ft. from E. Line

Ft. from W. Line

SE NE SE

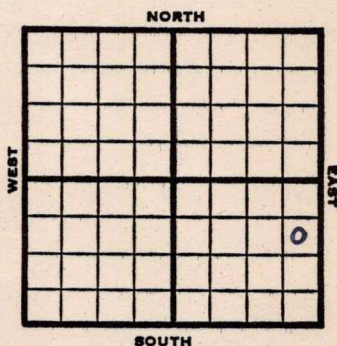

1953 Elev. 1883' REPORT

2/4 Spud 1-27-53
8" @ 205
Drlg. 1600'

2/12 TD 3321' 5" @ 3321' WOCT

2/19 DD 3329' 500 A NS
DD 3335' 1000 A

2/25 Spud 1-27-53 8" @ 205 TD 3335'
Lans 3051' Arb 3315 TD 3321
5" @ 3321 DD 3329 500 A
DD 3335 1000 A S/120 BO 5 hr.
2% wtr.
Comp. 35 BOPD 2% wtr.

COMPLETED

County Russell State Kans.

Sec. 30 (Blk. Twp.) 13 (Sur. Rge.) 14W Map No.

Operator Spurgeon etal.

Well No. 4 Farm Atherton

Elev.	Location	SE	NE	SE

FIRST REPORT

990 Ft. From N Line SE

330 Ft. From E Line Quarter

1st. Report FEB 4 1953

Completion

Remarks

Steams Drlg. - Contr.

Spudding Date 1-27-53

Drlg. Data

8" @ 205 drlg. 1600

J. G. McGEHEE

County Russell State Kansas

Sec. 30 (Blk. Twp.) 13 (Sur. Rge.) 14W Map No.

Operator Spurgeon et al.

Well No. 4 Farm Atherton

Elev.	1883	Location	SE NE SE
-------	------	----------	----------

COMPLETE

0

990 Ft. From N Line SE

330 Ft. From E Line Quarter

1st. Report

Completion FEB 25 1953

Remarks

Stearns Drlg. - Contr.

Spudding Date 1-27-53

Drilg. Data Oil well TD 3335

8" @ 205 Lans. 3051 Arb. 3315

TD 3321 5" @ 3321 DD 3329 500 A

DD 3335 1000 A S/ 120 bo 5 hr. 2% wtr.

Comp. 35 bopd 2% wtr.

J. G. McGEHEE