


SECTION 30 TOWNSHIP 13 RANGE 14W

WELL NO. #9 Atherton

COMPANY Kim Oil

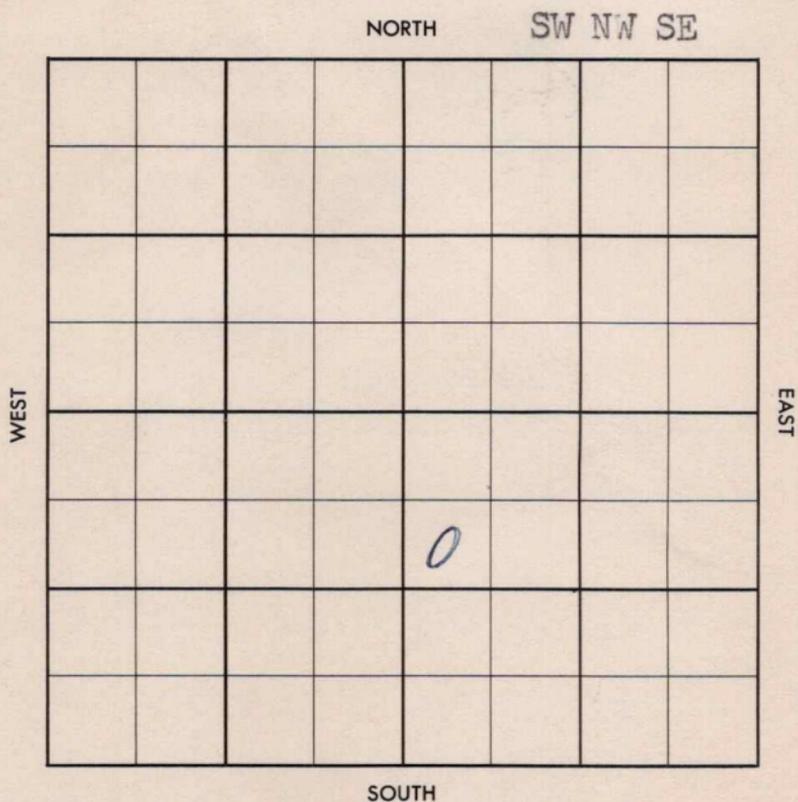

4426ET

FORM 513 SUNRAY

County Russell Elev. \_\_\_\_\_  
 Sec. 30 Twp. 13 Rge. 14W  
 Company Kim Oil  
 Farm Name Atherton No. 9

TOPS	DEPTH	LOG	DATUM	Loc. in Sec.
Anh.				SW NW SE
Tr.				
H.				
Dg.				
Bl.				
L.				Geol. _____
K.C.				Contr. _____
B.K.C.				<u>Shields</u>
Ce.				
C.				Pool _____
M.				<u>Russell</u>
M.				
K.				
Mz.				
Mq.				
V.				
S.				
S.				
A.				
R.				
PC.				
G.				
T.D.				

FIRST REPORT  
 JUN 19 '57  
 e

Date Comm. \_\_\_\_\_  
 Location                     

~~13~~

County Russell Elev. 1892  
 Sec. 30 Twp. 13 Rge. 14W  
 Company Kim Oil  
 Farm Name Atherton No. 9

TOPS	DEPTH	LOG	DATUM	Loc. in Sec.
Anh.	917			SW NW SE
Tp.				
H.	2991			
Tr. <u>Dodge</u>	3009			
Dg.				
Bl.				
L.	>3048			Geol.
K.C.				Contr.
B.K.C.				Shields
Ce.				Pool
C.	3293			Russell
M.				COMPLETE
M.				
K.				
Mz.				
Mo.				
V.				
S.				
S.				
A.	3309			
R.				
PE.				
G.				
TD.	3311			JUL 31 '57

Date Comm. Location JUN 26 '57 6-20-57 85/8  
923/450 1980 JUL 3 '57 113050  
JUL 10 '57 5 1/2 @ 3310 1/2 / CO  
3311 FU 2000' Fluid Pop JUL 17 '57  
JUL 24 '57 JUL 31 '57 P. 25 Bopd + Trace  
wt.