


Russell

KANSAS

Section 30 Township 13 Range 1W

Well No. #2 Dienes

Company Abe Steckle

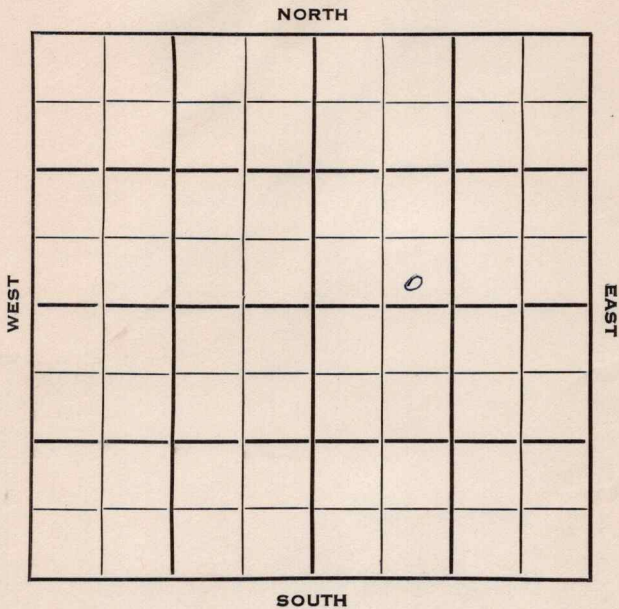

Russell KANSAS

Sec. 30 Twp. 13 R. 14 WWell No. # 2 Dienes FarmAbe Steckle CompanyStearns Contractor

Atherton Pool

Ft. from N. Line

330


Ft. from S. Line

Ft. from E. Line

990

Ft. from W. Line

SE SW NE

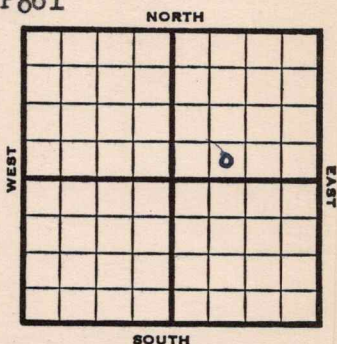

1953 Elev. 1874' REPORT

2/18

Spud 2-13-53

8" @ 940 Anhy 926'

2/26

Lans. 3045'

Drlg. 3260'

3/12

"

3/18

Spud 2-13-53

Oil Well

TD 3315

8" @ 940

Anhy 926, Tarkio 2535, Top. 2770, Heeb. 2993, Lans 3045

DST 2921-67, opn 3/4 hrs., rec. 20' mud, 750#

DST 3026-78, opn 1 hr., rec. 30' wcm

Marm. 3248, Shaley Arb. 3308, Arb. 3311

TD 3315

5" @ 3313


CO to 3315, FU 2500' oil 14 hrs.

S/5 boph

Comp. 25 bopd

COMPLETED

J. G. MCGEE

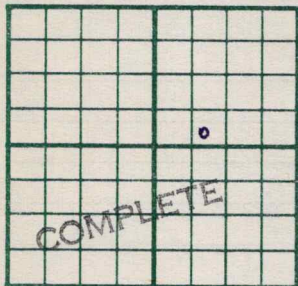County Russell State KansasSec. 30 (Blk.
Twps.) 13 (Sur.
Rge.) 14W Map No.Operator Abe SteckleWell No. 2 Farm DienesElev. 1874 Location SE SW NE330 Ft. From S Line NE990 Ft. From W Line Quarter

1st. Report

Completion MAR 1 8 1953Remarks Atherton PoolStearns - Contr.Spudding Date 2-13-53Drlg. Data Oil well TD 33158" @ 940 Anhy 926 Tarkio 2535Top. 2770 Heeb. 2993 Lans. 3045DST 2921-67 open 3/4 hr. Rec. 20' mud750# DST 3026-78 open 1 hr. Rec. 30'wcm Marm. 3248 Shaley Arb. 3308Arb. 3311 TD 3315 5" @ 3313 GO to3315 FU 2500' oil 14 hr. S/ 5 bophComp. 25 boph

J. G. McGEHEE