

Russell

Map No. **KANSAS** Sec. 30 Twp. 13 R. 14W


Well No. 1 - Down Farm _____
Phillips & Thomas Company

_____ Ft. from N. Line

990 Ft. from S. Line

330 Ft. from E. Line

_____ Ft. from W. Line

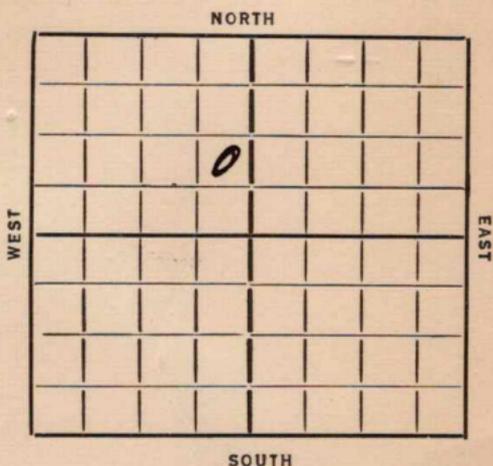

Elev. 1836

REPORT

O. W. D. D

~~1936~~
 2/12 Log.
 2/41 B/D
 2/28 Rig
 3/6 Dlg 590 13" 559
 3/13 " 1570 Aubry 8 1/2 10" 875
 3/20 8" - 2484 Drlg. 2495.
 3/27 T/D. 2943 U.R. 8".
 4/2 Drlg. 2976'
 4/10 T. Sil. 3269'. Show oil
 4/15 Sil 3293
 HFW 3319
 TD 3323
 D.O.D.

ABANDONED

O. W. D. D

1936
 10/21 Old total depth 3323'
 Drlg. 3535'
 10/29 Shut down.
 11/6 Grante wash 3590 T. D. 3624 SD

OVER

732851

1936

11/12--Shut down @ 3624'.

11/18--Granite Wash 3590 T. D. 3624
Take 90 bbls. water per hr.
water disposal.

ABANDONED

Map No. 72 Sec. 30 Twp. 13 R. 14W

Well No. 1-Down

Phillips & Glinae Company

Contractor

FIRST REPORTS

SECTION PLAT

	0		

.....Ft. from N. Line

990 Ft. from S. Line

330 Ft. from E. Line

.....Ft. from W. Line

Location.....

Rig up.....

Drilling and Remarks:

Log

RECORD

Cased.....in.,ft.

Sand.....

Gas.....

Oil.....

Total Depth.....

PRODUCTION

1st 24 hrs. Nat.....

1st 24 hrs. after shot.....

Gas.....Cu. Ft.

Dry Hole.....

Abandoned.....

Date

2-12-36 192

ORVAL MANNSCHRECK

Scout

Map No. 72 Sec. 30 Twp. 13 R. 14N

Well No. 1 Towne

Phillips & Glavin Oil Company

Contractor

SECTION PLAT

Ft. from N. Line

990 Ft. from S. Line

330 Ft. from E. Line

Ft. from W. Line

ABANDONED

	0		

Location

Rig up

Drilling and Remarks:

Sil 3293

AFW 3319

AAA

RECORD

Cased in., ft.

Sand

Gas

Oil

Total Depth 3323

PRODUCTION

1st 24 hrs. Nat.

1st 24 hrs. after shot

Gas Cu. Ft.

Dry Hole

Abandoned

Date

APR 15 1936 192

S. J. LEWIS

Scout

KANSAS

Map No. 72 Sec. 30 Twp. 13 R. 14W

Well No. 1 Jones

Phillips & Gal Company

Contractor

SECTION PLAT

	0		

_____ Ft. from N. Line

990 Ft. from S. Line

320 Ft. from E. Line

_____ Ft. from W. Line

FIRST REPORT

O.W.D.D. **O.W.D.D.**

Location _____

Rig up _____

Drilling and Remarks:

0166723323

2193535

RECORD

Cased _____ in., _____ ft.

Sand _____

Gas _____

Oil _____

Total Depth _____

PRODUCTION

1st 24 hrs. Nat. _____

1st 24 hrs. after shot _____

Gas _____ Cu. Ft.

Dry Hole _____

Abandoned _____

Date

OCT 21 1936 19

S. J. LEWIS Scout

