


Russell

KANSAS

SECTION 30 TOWNSHIP 13S RANGE 14W

WELL NO. #10 Atherton

COMPANY Kim Oil

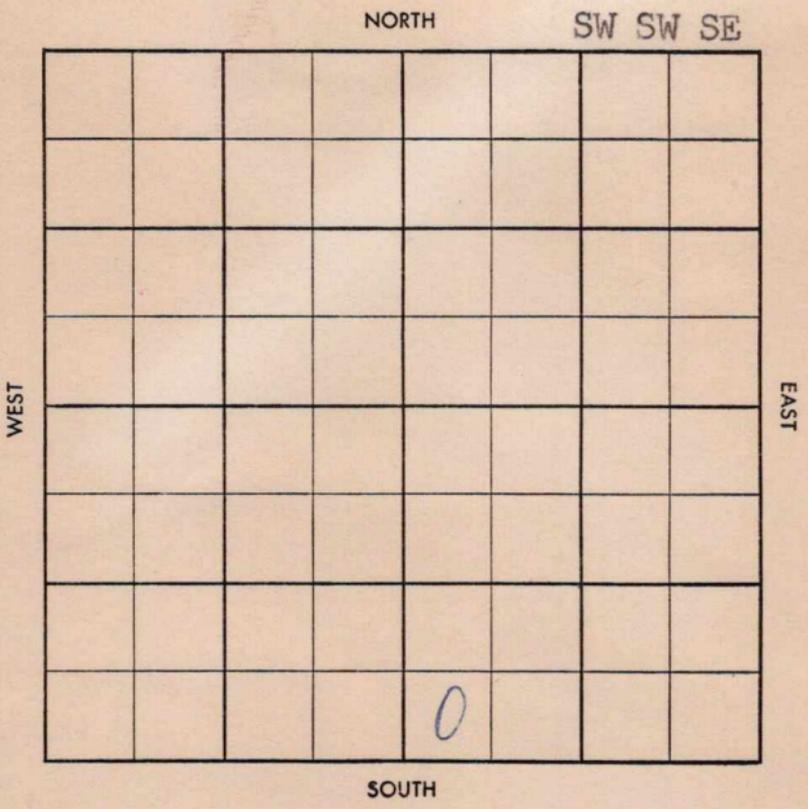

CO. ~~Russell~~
 SEC. 30 TWP. 13 RGE. 14W
 COMPANY Kim Oil NO. 10
 ELEV. 1583

COMPLETE

NOV 6 '57

0

FARM

Atherton

LOC.

SM SW SE

GEOL.

CONTR. Shields

POOL

Russell

SPUD

9-21-57

8" @ 932/450

dr. 1140

pipe set

5 1/2 334 1/2

W 3332

SSG

T/D3336

H 3332

L 3045

TR 3011

H 2993

Anhy 915

B 109004 m 2000A

pop

F45B0 NW 24hs

25 Bopd m