


Section 29 Township 28 Range 4E

Well No. 4 Duvenall *(Duvenall)*

Company Rooks-Hall

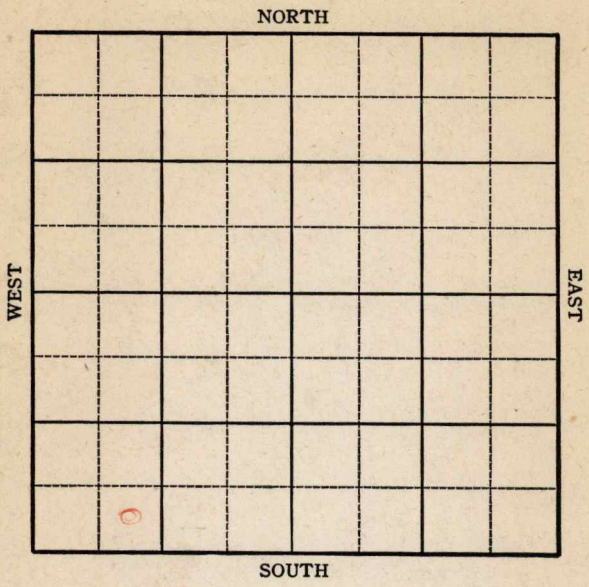

Sec. 29 Twp. 28 R. 4-E

Well No. #4 Duvenall Farm


Rooks-Hall Company

\_\_\_\_\_ Ft. from N. Line

330 Ft. from S. Line

\_\_\_\_\_ Ft. from E. Line

990 Ft. from W. Line

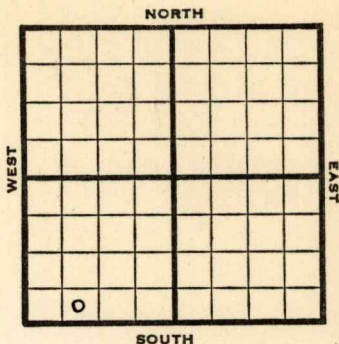

SE SW SW

1945 **Elev. 1256** REPORT

- 11/14 Machine
- 11/21 Drlg. 412
- 11/28 755 fishing
- 12/5 Drlg. 1045'
- 12/12 12" @ 527  
Drlg. 1325
- 12/20 SD 1335'
- 12/29 "
- 1946 "
- 1/10 "
- 1/17 Drlg. 1340'
- 1/24 P.B. to 775' Bit in hole.
- 1/31 Drlg. 1150'
- 2/7 8" - 1720' C.O.
- 2/14 6" - 2180' Drlg. 2200'
- 2/21 **Lans. 1730' K.C. 2055'**  
**Arb. 2518' T.D. 2519'**  
5" - 2519' WOC.
- 2/28 T.D. 2535' 300' oil.  
250 acid.
- 3/6 **Arb. 2518**  
5" @ 2519  
1750 acid.  
TD 2535  
Pump 80 Pot.  
Grav. 36.0

**COMPLETED**



Kansas Pool Name Miscellaneous

**KANSAS**  
 Map No. 11 Sec. 29 Twp. 28 R. 4E

Well No. 4 Duvenall

Rocks-Hall Company

**COMPLETED**

Contractor

SE SW SW

*E11256*

**SECTION PLAT**

\_\_\_\_\_ Ft. from N. Line

330 Ft. from S. Line

\_\_\_\_\_ Ft. from E. Line

990 Ft. from W. Line


Butler County

Location \_\_\_\_\_

Rig up \_\_\_\_\_

Drilling and Remarks:

*cut 2578.  
 5" @ 2579  
 1250 acid  
 Pump 80 P.D.  
 360-92*

**RECORD**

Cased \_\_\_\_\_ in., \_\_\_\_\_ ft.

Sand \_\_\_\_\_

Gas \_\_\_\_\_

Oil \_\_\_\_\_

Total Depth 2585

**PRODUCTION**

1st 24 hrs. Nat. \_\_\_\_\_

1st 24 hrs. after shot \_\_\_\_\_

Gas \_\_\_\_\_ Cu. Ft.

Dry Hole \_\_\_\_\_

Abandoned \_\_\_\_\_

Date

MAR 6 1946 19

S. J. LEWIS Scout