


Russell

KANSAS

SECTION 31 TOWNSHIP 13S RANGE 14W

WELL NO. #3 Brown

COMPANY Icer Addis

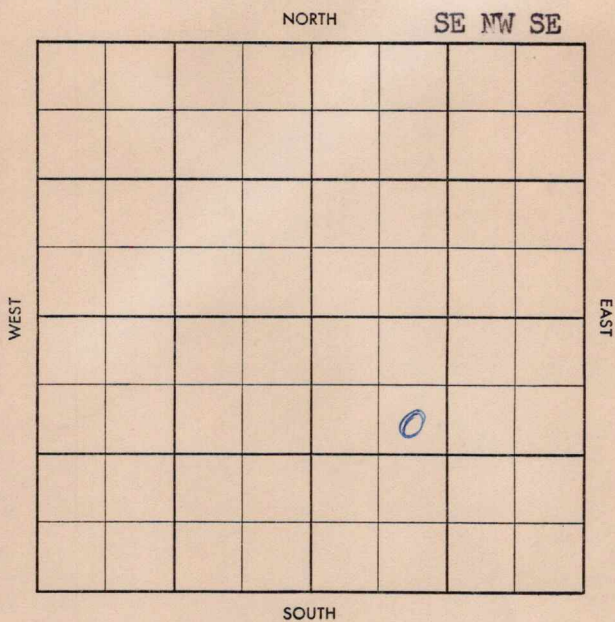

P28557 ~~X~~ Twp. ~~X~~ Pool ~~X~~  
~~X~~ Geol. ~~X~~ Facet ~~X~~

S-513-B

County Russell Elev. \_\_\_\_\_  
 Sec. 31 Twp. 13 Rge. 14W  
 Company Icer Addis  
 Farm Name Brown No. 3

TOPS	DEPTH	LOG	DATUM
Anh. _____	<u>904</u>		
Tp. _____			
H. _____			
Tr. _____			
Dg. _____			
B.L. _____			
L. _____			
K.C. _____			
B.K.C. _____			
Ce. _____			
C. _____			
M. _____			
M. _____			
K. _____			
Mz. _____			
Mq. _____			
V. _____			
S. _____			
S. _____			
A. _____			
R. _____			
Pf. _____			
G. _____			
T.D. _____			

Loc. in Sec. \_\_\_\_\_  
SE NW SE  
 Geol. D. Vaughan  
 Contr. \_\_\_\_\_  
Triangle  
 Pool \_\_\_\_\_  
Russell



Date Comm. 3/28/58  
8" @ 904 w/425, Drlg. 1200

Co. \_\_\_\_\_  
 Lse. \_\_\_\_\_  
 No. \_\_\_\_\_  
 Sec. \_\_\_\_\_  
 T. \_\_\_\_\_  
 R. \_\_\_\_\_

Twp. ~~-----~~ Pool ~~-----~~  
 Co. ~~-----~~ Facet ~~-----~~

S-513-B

County Russell Elev. 18630 1867 RB  
 Sec. 31 Twp. 13 Rge. 14W  
 Company Icer Addis  
 Farm Name Brown No. 3

TOPS	DEPTH	LOG	DATUM
Anh.	904		
Tp.	2752		
H.	2974		
Tr.	2994		
Dg.			
B.L.			
L.	3027		
K.C.			
B.K.C.			
Ce.			
C.			
M.			
M.			
K.			
Mz.			
Mq.			
V.			
S.			
S.			
A.	3300		
R.			
Pf.			
G.			
T.D.	3311		

Loc. in Sec. SE NW SE  
 Geol. D. Vaughan  
 Contr. Triangle  
 Pool Russell

COMPLETE  
 23 58

Date Comm. 3/28/58  
 8" @ 904 w/425, Drlg. 1200 APR 9 58 DST  
 3045-60 op/hr 8' M BHP  
 400/20" DST 3179-3200 1hr  
 8' M BHP 390/20" DST 3296-  
 3307 op 30" 10' M / 550 BHP  
 995/15" DST 3295-3311 op 1hr  
 310 frigg oil BHP 1000/20 FPO  
 -235 no log 5 1/2" 3307/  
 APR 15 58 APR 23 58 CO 3311 FU 2420' oil  
 12hrs @ 5 1/2 BHP PH NW 6hrs POP

P 25 Bopd NW

ant open hole