

Russell

KANSAS

Sec. 31 Twp. 13 R. 14W

Well No. #3 Brown Farm

Murfin Drlg. Company

Murfin Drlg. - Contr. Contractor

Atherton Pool


990' Ft. from N. Line

_____ Ft. from S. Line

330' Ft. from E. Line

_____ Ft. from W. Line

SE NE SE

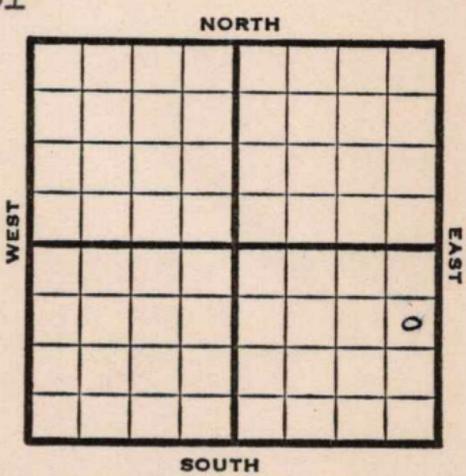

1950

Elev. 1864' REPORT

11/15

RUR

1951

1/10

Spud 11-14-50
 Oil Well TD 3315
 8" @ 564' Anhy 904
 Heeb. 3979 Dodge 2998
 Lans. 3031 Arb. 3299-3302
 5" @ 3299 TD 3307 500 A
 DD 3315 300 A S/3 boph
 Comp. 20 bopd

COMPLETED

