


Map No. _____ Sec. 29 Twp. 28 R. 4Well No. 98-Lane Farm __________Empire_____
Company

NORTH

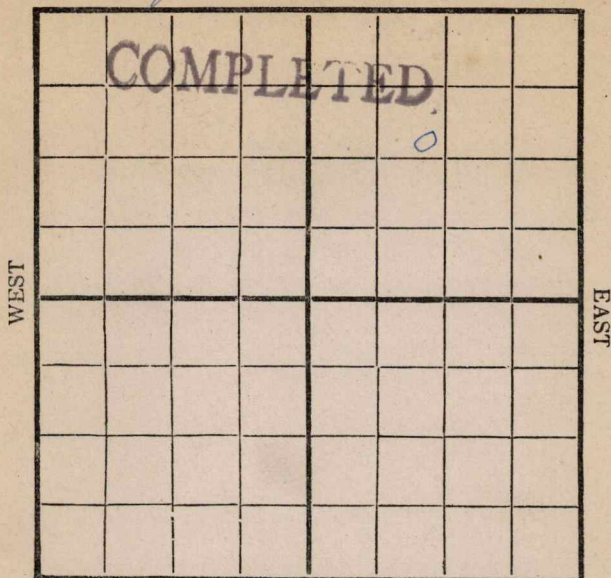

SOUTH

Location ✓ ✓Rig Up 12-4-16

Drilling Remarks:

Drilling Remarks:

12/11=12/1870' 12/28590 = 1/8/17765 = 1/15

RECORD

PRODUCTION

Cased _____ in _____ Ft.

1st 24 hrs. Nat. _____

Sand _____

1st 24 hrs. after shot _____

Gas _____

Gas _____ Cu. Ft.

Oil _____

Dry Hole _____

Total Depth _____


Abandoned _____

Map No. _____ Sec. 29 Twp. 28 R. 4Well No. 8 Love Farm _____Company Enterprise

NORTH

WEST

EAST

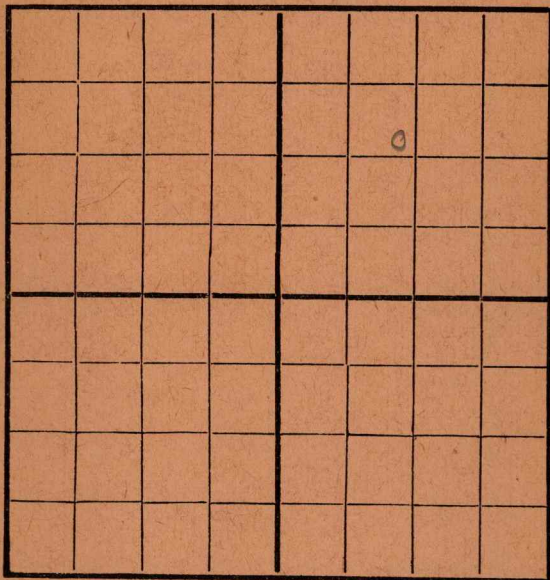

SOUTH

Location _____

Rig Up ☒ _____

Drilling and remarks _____

RECORD

Cased _____ in. _____ Ft.

Sand _____

Gas _____

Oil _____

Total Depth _____

PRODUCTION

1st 24 hrs. Nat. _____

1st 24 hrs. after shot _____

Gas _____ Cu. Ft.

Dry Hole _____

Abandoned _____

Date

12/4/1916


Cordry Scout

Map No. _____ Sec. 29 Twp. 28 R. 4
 Well No. 8 Lone Farm _____
Engine Company _____

NORTH

WEST

EAST

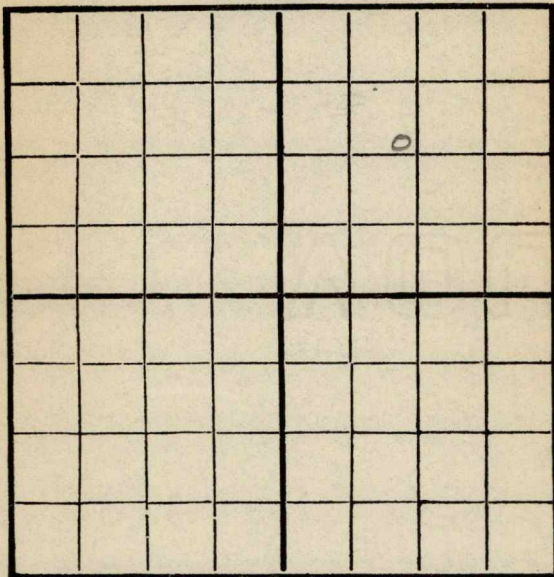

SOUTH

Location _____
 Rig Up _____
 Drilling and remarks _____

RECORD

Cased _____ in. _____ Ft.
 Sand _____
 Gas _____
 Oil _____
 Total Depth _____

PRODUCTION

1st 24 hrs. Nat. _____
 1st 24 hrs. after shot _____
 Gas _____ Cu. Ft.
 Dry Hole _____
 Abandoned _____

Date


12/11, 1916 C. C. C. Scout

Map No. _____ Sec. 29 Twp. 28 R. 4Well No. 8 Lone Farm _____Company Overland

NORTH

WEST

EAST

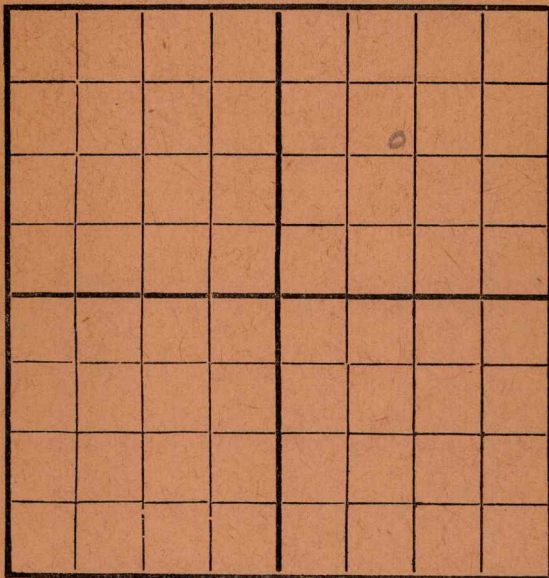

SOUTH

Location _____

Rig Up ☒ _____

Drilling and remarks _____

RECORD

Cased _____ in. _____ Ft.

Sand _____

Gas _____

Oil _____

Total Depth _____

PRODUCTION

1st 24 hrs. Nat. _____

1st 24 hrs. after shot _____

Gas _____ Cu. Ft.

Dry Hole _____

Abandoned _____


Date

12/18, 1916 Cordell Scout

Map No. _____ Sec. 28 Twp. 28 R. 4
 Well No. 9 Farm _____
 _____ Company _____

NORTH

WEST

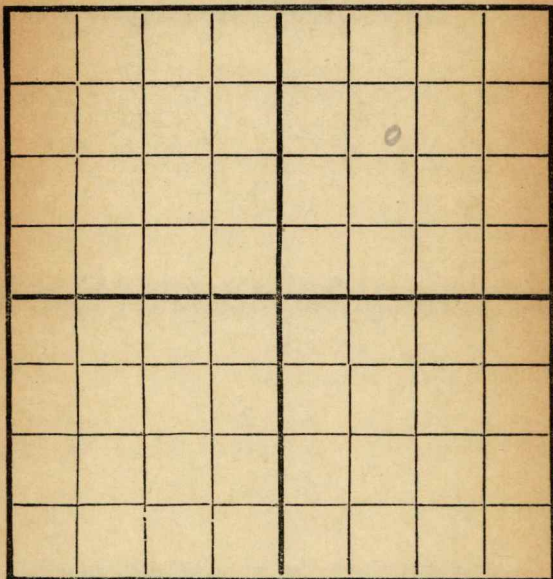

EAST

SOUTH

Location _____
 Rig Up _____
 Drilling and remarks _____

70'

RECORD

Cased _____ in. _____ Ft.
 Sand _____
 Gas _____
 Oil _____
 Total Depth _____

PRODUCTION

1st 24 hrs. Nat. _____
 First 24 hrs. after shot _____
 Gas _____ Cu. Ft.
 Dry Hole _____
 Abandoned _____


Date

12/28, 1916 C. C. C. Scout

Map No. _____ Sec. 29 Twp. 28 R. 4
 Well No. 9 Lane Farm _____
Empire Company

NORTH

WEST

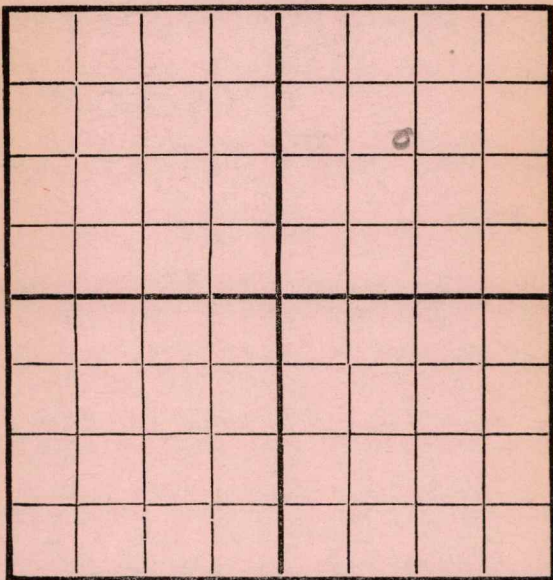

EAST

SOUTH

Location _____
 Rig Up _____
 Drilling and remarks _____

RECORD

Cased _____ in. _____ Ft.
 Sand _____
 Gas _____
 Oil _____
 Total Depth _____

PRODUCTION

1st 24 hrs. Nat. _____
 First 24 hrs. after shot _____
 Gas _____ Cu. Ft.
 Dry Hole _____
 Abandoned _____

Date

1/1, 191 2 Carney Scout

Map No. _____ Sec. 29 Twp. 28 R. 4

Well No. 4202 Farm _____

Company

NORTH

WEST

EAST

SOUTH

Location _____

Rig Up-----

Drilling and remarks

570

RECORD

Cased_____in. _____Ft.

Sand_____

Gas _____

Oil_____

Total Depth_____

PRODUCTION

1st 24 hrs. Nat. _____

1st 24 hrs. after shot-----

Gas-----Cu. Ft.

Dry Hole-----

Abandoned_ _ _ _ _

Date _____

191

Scout

Map No. _____ Sec. 29 Twp. 28 R. 4
 Well No 9 Loose Farm
Empire Company

NORTH

WEST

EAST

SOUTH

Location _____
 Rig Up _____
 Drilling and remarks

RECORD

Cased _____ in. _____ Ft.
 Sand _____
 Gas _____
 Oil _____
 Total Depth _____

PRODUCTION

1st 24 hrs. Nat. _____
 1st 24 hrs. after shot _____
 Gas _____ Cu. Ft.
 Dry Hole _____
 Abandoned _____


Date

1/15 7 Card 191 _____ Scout

Map No. _____ Sec. 29 Twp. 38 R. 4
 Well No. 9-Long Farm _____
Empire Company _____

NORTH

WEST

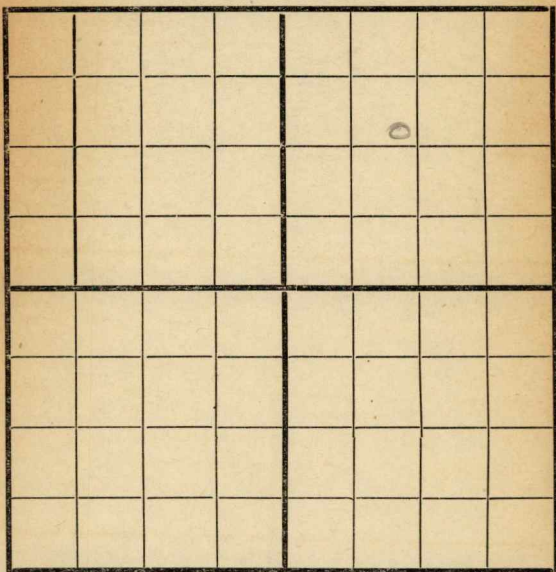

EAST

SOUTH

Location _____

Rig Up _____

Drilling and remarks

RECORD

Cased _____ in. _____ Ft.

Sand _____

Gas _____

Oil _____

Total Depth _____

PRODUCTION

1st 24 hrs. Nat. _____

1st 24 hrs. after shot _____

Gas _____ Cu. Ft.

Dry Hole _____

Abandoned _____

Date

191

Scout

Map No. _____ Sec. 29 Twp. 28 R. 4
 Well No. 9 Lone _____ Farm
Engine _____ Company

NORTH

WEST

EAST

SOUTH

Location _____

Rig Up _____

Drilling and remarks

1230'

RECORD

Cased _____ in. _____ Ft.

Sand _____

Gas _____

Oil _____

Total Depth _____

PRODUCTION

1st 24 hrs. Nat. _____

1st 24 hrs. after shot _____

Gas _____ Cu. Ft.

Dry Hole _____


Abandoned _____

Date

1/29, 1917 Cordiff Scout

Map No. _____ Sec. 29 Twp. 28 R. 4
 Well No. 9 _____ Farm _____
Empire Company

NORTH

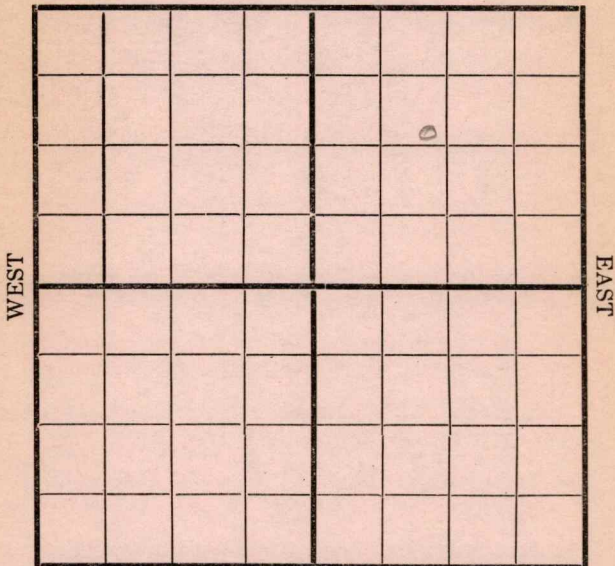

SOUTH

Location _____
 Rig Up _____
 Drilling and remarks _____

1335'

RECORD

Cased _____ in. _____ Ft.
 Sand _____
 Gas _____
 Oil _____
 Total Depth _____


PRODUCTION

1st 24 hrs. Nat. _____
 1st 24 hrs. after shot _____
 Gas _____ Cu. Ft.
 Dry Hole _____
 Abandoned _____

Date

2/5, 1917 Condy Scout

Map No. _____ Sec. 29 Twp. 28 R. 4
 Well No. 9 Lane Farm _____
Empire Company _____
 NORTH

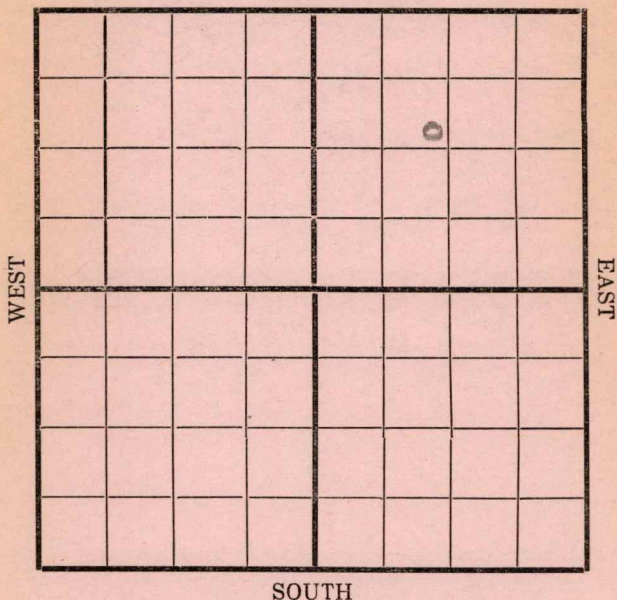

Location _____
 Rig Up _____
 Drilling and remarks

1500'

RECORD

Cased _____ in. _____ Ft.
 Sand _____
 Gas _____
 Oil _____
 Total Depth _____

PRODUCTION

1st 24 hrs. Nat. _____
 1st 24 hrs. after shot _____
 Gas _____ Cu. Ft.
 Dry Hole _____
 Abandoned _____


Date 2/12 1917 Empire Scout

Map No. _____ Sec. 29 Twp. 28 R. 4
 Well No. 9 _____ Farm _____
Empire _____ Company _____

NORTH

WEST

EAST

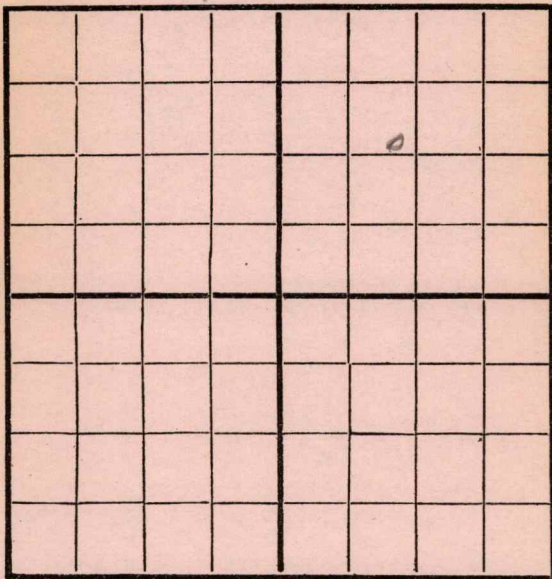

SOUTH

Location _____
 Rig Up _____
 Drilling and remarks _____

RECORD

Cased _____ in. _____ Ft.
 Sand _____
 Gas _____
 Oil _____
 Total Depth _____

PRODUCTION

1st 24 hrs. Nat. _____
 1st 24 hrs. after shot _____
 Gas _____ Cu. Ft.
 Dry Hole _____
 Abandoned _____


Date 9/19, 1917 C. L. Cardiff Scout

Map No. _____ Sec. 29 Twp. 28 R. 4
 Well No. 9 Lone Farm _____
Company Company _____

NORTH

WEST

EAST

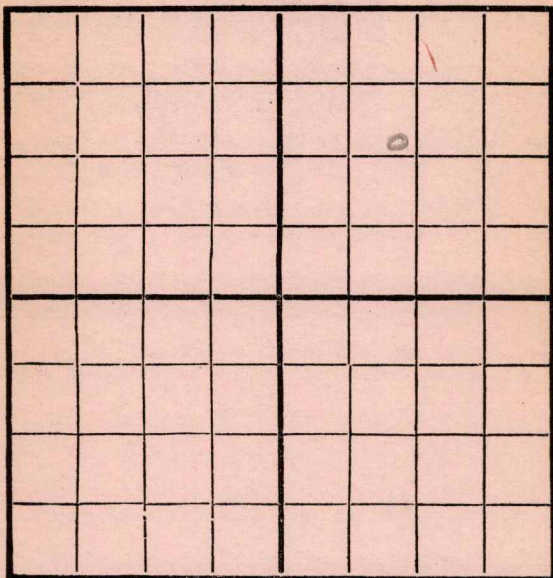

SOUTH

Location _____
 Rig Up _____
 Drilling and remarks _____

1900

RECORD

Cased _____ in. _____ Ft.
 Sand _____
 Gas _____
 Oil _____
 Total Depth _____

PRODUCTION

1st 24 hrs. Nat. _____
 First 24 hrs. after shot _____
 Gas _____ Cu. Ft.
 Dry Hole _____
 Abandoned _____


Date Feb 2, 1911 Carry Scout _____

Map No. _____ Sec. 39 Twp. 28 R. 4
 Well No. 9 Love Farm _____
Engine Company _____

NORTH

WEST

EAST

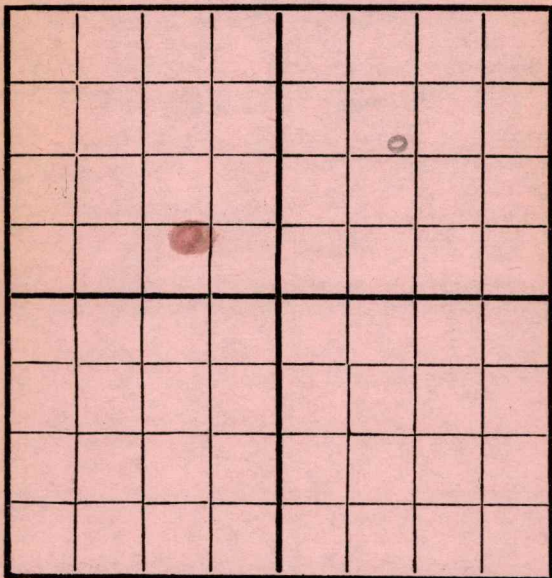

SOUTH

REMARKS:

*Shut Down
1900*

Date

3/5, 1912 Condy Scout

Map No. _____ Sec. 29 Twp. 28 R. 4Well No. 9 Love Farm _____Company Cummins

NORTH

WEST

EAST

SOUTH

Location _____

Rig Up _____

Drilling and remarks

Fishing
1900'

RECORD

Cased _____ in. _____ Ft.

Sand _____

Gas _____

Oil _____

Total Depth _____

PRODUCTION

1st 24 hrs. Nat. _____

1st 24 hrs. after shot _____

Gas _____ Cu. Ft.

Dry Hole _____

Abandoned _____

Date


3/2, 1917 Early Scout

Map No. _____ Sec. 29 Twp. 28 R. 4
 Well No. 9 Love Farm _____
Empire Company _____

NORTH

WEST

EAST

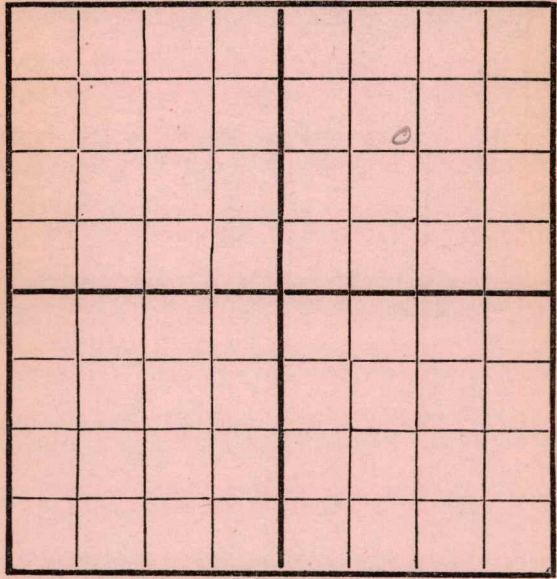

SOUTH

Location _____
 Rig Up _____
 Drilling and remarks _____

1900

RECORD

Cased _____ in. _____ Ft.
 Sand _____
 Gas _____
 Oil _____
 Total Depth _____

PRODUCTION


1st 24 hrs. Nat. _____
 1st 24 hrs. after shot _____
 Gas _____ Cu. Ft.
 Dry Hole _____
 Abandoned _____

Date 3/9, 1917 Candis Scout _____

Map No. _____ Sec. 29 Twp. 28 R. 4
 Well No. 9 Lane Farm _____
Empire Company _____

NORTH

WEST

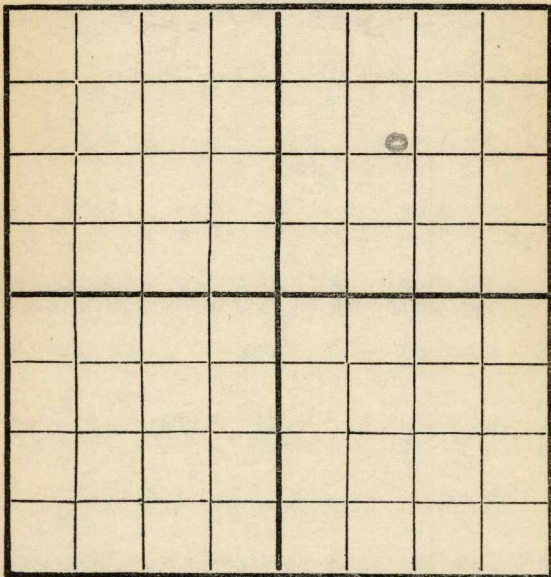

EAST

SOUTH

Location _____

Rig Up _____

Drilling and remarks

Fishing
1900'

RECORD

Cased _____ in. _____ Ft.

Sand _____

Gas _____

Oil _____

Total Depth _____

PRODUCTION

1st 24 hrs. Nat. _____

1st 24 hrs. after shot _____

Gas _____ Cu. Ft.

Dry Hole _____

Abandoned _____

Date

3/26 191 *7* *Carley* Scout

Map No. _____ Sec. 29 Twp. 28 R. 4Well No. 9. Horse Farm _____Engine Company _____

NORTH

WEST

EAST

SOUTH

Location _____

Rig Up _____

Drilling and remarks

Fishing 1900

RECORD

Cased _____ in. _____ Ft.

Sand _____

Gas _____

Oil _____

Total Depth _____

PRODUCTION

1st 24 hrs. Nat. _____

First 24 hrs. after shot _____

Gas _____ Cu. Ft.


Dry Hole _____

Abandoned _____

Date

4/4, 191 7 Conley Scout

Map No. _____ Sec. 29 Twp. 28 R. 4
 Well No. 9 Love Farm _____
Engine Company _____
 NORTH

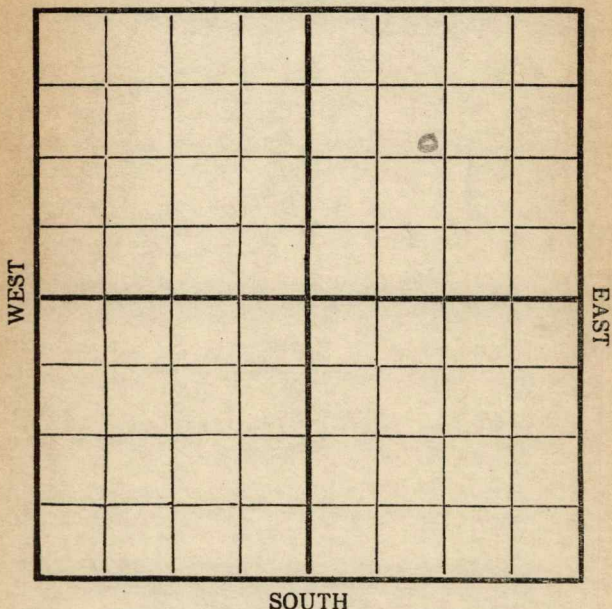

SOUTH

Location _____
 Rig Up _____
 Drilling and remarks _____

Fishing
1900'

RECORD

Cased _____ in. _____ Ft.
 Sand _____
 Gas _____
 Oil _____
 Total Depth _____

PRODUCTION

1st 24 hrs. Nat. _____
 1st 24 hrs. after shot _____
 Gas _____ Cu. Ft.
 Dry Hole _____
 Abandoned _____

Date

4/10, 1917 *Conley* Scout

Map No. _____ Sec. 29 Twp. 28 R. 4Well No. 9 Love Farm _____Engine Company _____

NORTH

WEST

EAST

SOUTH

Location _____

Rig Up _____

Drilling and remarks

Fishing
1900'

RECORD

Cased _____ in. _____ Ft.

Sand _____

Gas _____

Oil _____

Total Depth _____

PRODUCTION

1st 24 hrs. Nat. _____

1st 24 hrs. after shot _____

Gas _____ Cu. Ft.

Dry Hole _____

Abandoned _____

Date


4/17, 1917 Cord Scout _____

Map No. _____ Sec. 29 Twp. 28 R. 4
 Well No. 9 Love _____ Farm
Engine _____ Company

NORTH

WEST

EAST

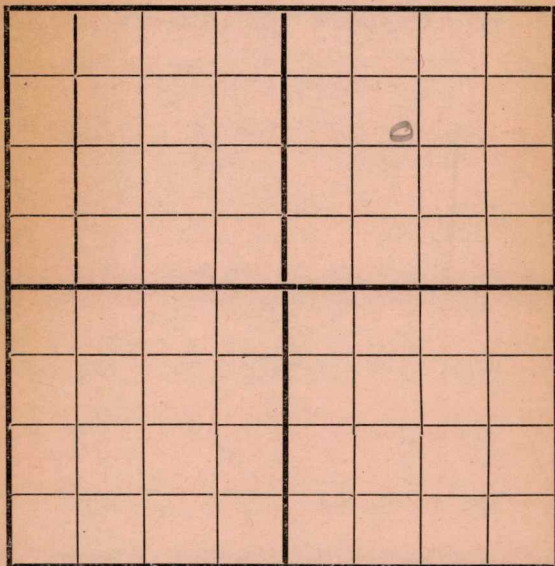

SOUTH

Location _____

Rig Up _____

Drilling and remarks

2380'

RECORD

Cased _____ in. _____ Ft.

Sand _____

Gas _____

Oil _____

Total Depth _____

PRODUCTION

1st 24 hrs. Nat. _____

1st 24 hrs. after shot _____

Gas _____ Cu. Ft.

Dry Hole _____

Abandoned _____

Date

4/24, 1917 Carly _____ Scout

Map No. _____ Sec. 29 Twp. 28 R. 4
 Well No. 9 Loss Farm _____
 _____ Company

NORTH

WEST

EAST

SOUTH

Location _____
 Rig Up _____
 Drilling and remarks

RECORD

Cased _____ in. _____ Ft.
 Sand _____
 Gas _____
 Oil _____
 Total Depth _____

PRODUCTION

1st 24 hrs. Nat. _____
 1st 24 hrs. after shot _____
 Gas _____ Cu. Ft.
 Dry Hole _____
 Abandoned _____

*Shut Down
 at 2380'*


Date 5/2, 1917 C. C. C. Scout

Map No. _____ Sec. 29 Twp. 28 R. 4Well No. 9 Fore _____ Farm

_____ Company

NORTH

WEST

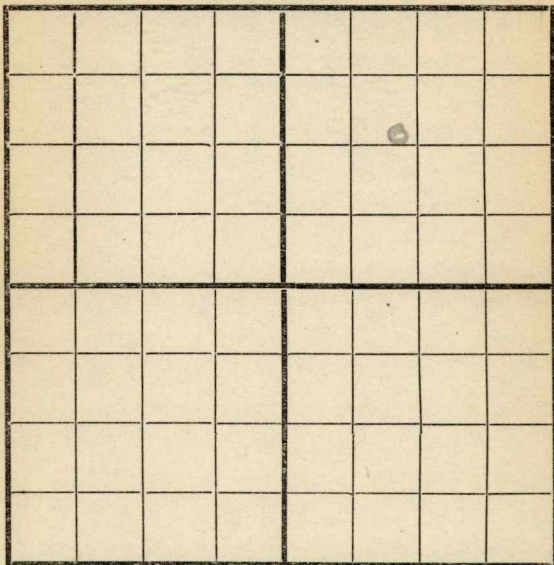

EAST

SOUTH

Location _____

Rig Up _____

Drilling and remarks

Shut Down
2380

RECORD

Cased _____ in. _____ Ft.

Sand _____

Gas _____

Oil _____

Total Depth _____

PRODUCTION

1st 24 hrs. Nat. _____

1st 24 hrs. after shot _____

Gas _____ Cu. Ft.

Dry Hole _____

Abandoned _____

Date

3/8, 191 *7* *Cond.* Scout

Map No. _____ Sec. 27 Twp. 28 R. 4Well No. 9 _____ Farm _____

_____ Company _____

NORTH

WEST

EAST

SOUTH

Location _____

Rig Up _____

Drilling and remarks

*skidded
Rig and
spinning*

RECORD

Cased _____ in. _____ Ft.

Sand _____

Gas _____

Oil _____

Total Depth _____

PRODUCTION

1st 24 hrs. Nat. _____

1st 24 hrs. after shot _____

Gas _____ Cu. Ft.

Dry Hole _____

Abandoned _____

Date

5/25/1917 _____ Scout

Map No. _____ Sec. 29 Twp. 28 R. 4Well No. 9 _____ Farm _____

_____ Company _____

NORTH

WEST

EAST

SOUTH

Location _____

Rig Up _____

Drilling and remarks

Skipped Rig
Had bad
fishing job
Spudding

RECORD

Cased _____ in. _____ Ft.

Sand _____

Gas _____

Oil _____

Total Depth _____

PRODUCTION

1st 24 hrs. Nat. _____

1st 24 hrs. after shot _____

Gas _____ Cu. Ft.

Dry Hole _____

Abandoned _____

Date

5/29 191 7 *Carbide* Scout

Map No. _____ Sec. 29 Twp. 38 R. 4Well No. 9 Lone Farm _____

Company _____

NORTH

WEST

EAST

SOUTH

Location ✓Rig Up ✓

Drilling and remarks

*This Rig
was skidded
from old hole*

RECORD

Cased _____ in. _____ Ft.

Sand _____

Gas _____

Oil _____

Total Depth _____

PRODUCTION

1st 24 hrs. Nat. _____

1st 24 hrs. after shot _____

Gas _____ Cu. Ft.

Dry Hole _____

Abandoned _____

Date

6/8, 1917 Cordiff Scout

MAP NO. K11-KANSAS SEC. 29 TWP. 58S R. 4E

WELL NO. 9 Lone

Empire COMPANY

CONTRACTOR

ABANDONED

SECTION PLAT

_____ FT. FROM N. LINE

_____ FT. FROM S. LINE

_____ FT. FROM E. LINE

_____ FT. FROM W. LINE

LOCATION _____

RIG UP _____

DRILLING AND REMARKS:

2380

RECORD

CASED _____ IN. _____ FT.

SAND _____

GAS _____

OIL _____

TOTAL DEPTH 1900

PRODUCTION

1ST 24 HRS. NAT. _____

1ST 24 HRS. AFTER SHOT _____

GAS _____ CU. FT.

DRY HOLE ☒


ABANDONED ☒

DATE

5-16 1917

SCOUT

Map No. _____ Sec. 29 Twp. 28 R. 4
 Well No. 9 foot Farm _____
Pennine Company _____
 NORTH

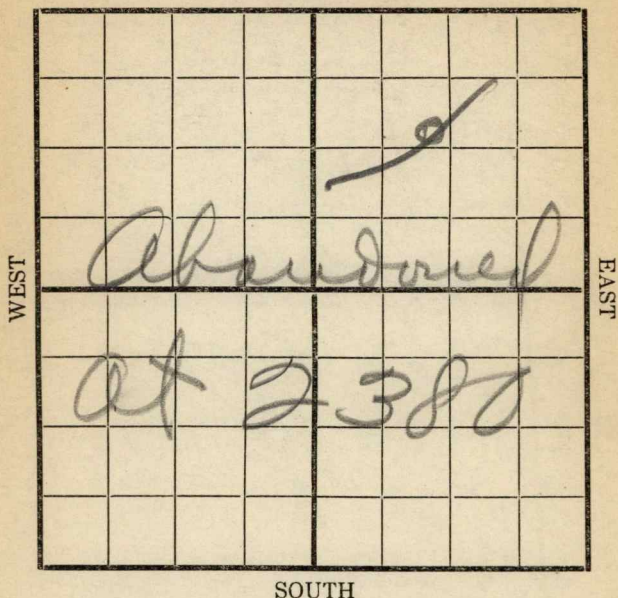

SOUTH

Location _____

Rig Up _____

Drilling and remarks

*This
has been
Abandoned*

RECORD

Cased _____ in. _____ Ft.

Sand _____

Gas _____

Oil _____

Total Depth _____

PRODUCTION

1st 24 hrs. Nat. _____

1st 24 hrs. after shot _____

Gas _____ Cu. Ft.

Dry Hole _____

Abandoned _____

Date

6/12, 1912 Cordiff Scout