


Section 31 Township 13 Range 14W

Well No. 1 Brown

Company Phil-Han etal

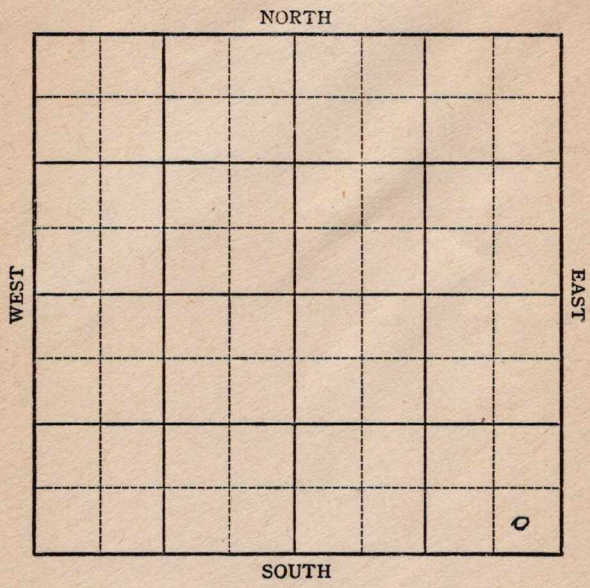

KANSAS

Russell

Sec. 31 Twp. 13 R. 14-W

Well No. #1 Brown Farm


Phil-Han etal Company
Russell Pool

 Ft. from N. Line

330 Ft. from S. Line

330 Ft. from E. Line

 Ft. from W. Line

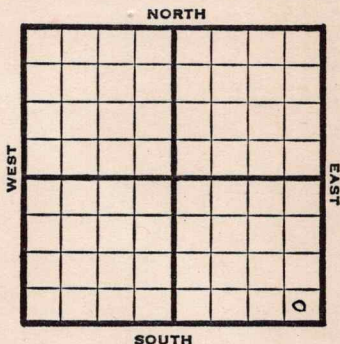

SE/C

REPORT

1947 Elev. 1851'

4/16 Location

4/23 "

4/29 8" @ 535'
Drlg. 2700'

5/7 **Lans 3016**
Arb 3289-92
TD 3292'
5" @ 3290
To Perforate Lansing

5/13 24 shots 3030-20'
4000 Acid
24 shots 3031-40' CO

5/20 Squeeze Perf 58 shots 3042-67
500 acid

5/27 TD 3292'

6/3 32 shots
2910 to 18-2000 base W
Squeeze

6/10 " " "

6/17 " " "

OVER

1947

732877

6/25

TD 3292'

Arbuckle 3289'

5" @ 3290

Pump 75 Pot.

41 0 GR.

Complete

COMPLETED

Map No. K72 Sec. 31 Twp. 13 R. 14W

Well No. 1 Brown

Phil-Han et al. Company

FIRST REPORT Contractor

SE/C


SECTION PLAT

 Ft. from N. Line

330 Ft. from S. Line

330 Ft. from E. Line

 Ft. from W. Line

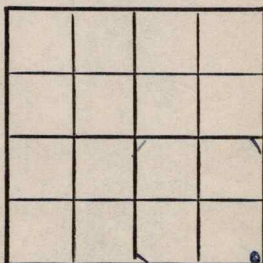

Russell County

Location X

Rig up

Drilling and Remarks:

RECORD

Cased in., ft.

Sand

Gas

Oil

Total Depth

PRODUCTION

1st 24 hrs. Nat.

1st 24 hrs. after shot

Gas Cu. Ft.

Dry Hole

Abandoned

Date

APR 16 1947 19

S. J. LEWIS Scout

Map No. 72 Sec. 31 Twp. 13 R. 14W

Well No. 1 Brown

Phil-Han etal. _____ Company

COMPLETE

Contractor

SE/C

21. 1857.

SECTION PLAT

Ft. from N. Line

330 Ft. from S. Line

330 Ft. from E. Line

Ft. from W. Line

Russell County

RECORD

Location _____

Cased _____ in., _____ ft.

Rig up_____

Sand

Drilling and Remarks:

Gas _____

Oil _____

Total Depth 3294

PRODUCTION

1st 24 hrs. Nat. _____

1st 24 hrs. after shot_____

Gas_____ Cu. Ft.

Dry Hole_____

Abandoned

Date _____

JUN 25 1947 19

S. J. LEWIS

Scout