


Section 31 Township 13 Range 14W

Well No. #1 Brown

Company Alyward

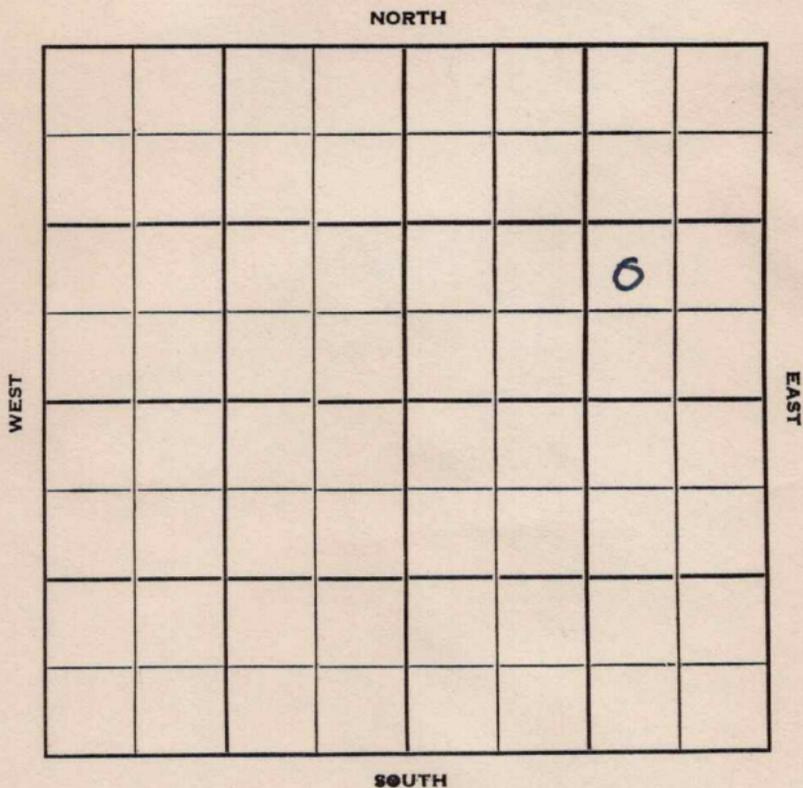

Sec. 31 Twp. 13 R. 14W

Well No. #1 Brown Farm

Alyward Company

Alyward Contractor

Ft. from N. Line


990

Ft. from S. Line

990

Ft. from E. Line

Ft. from W. Line

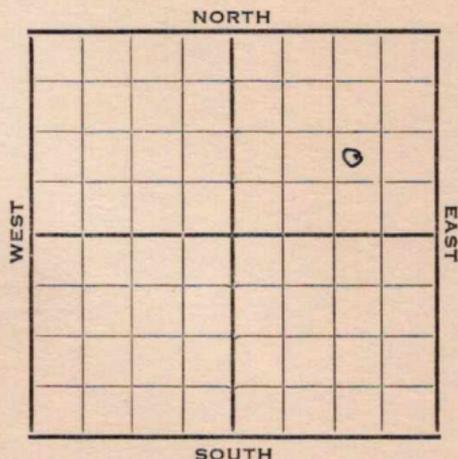

NW SE NE

1952

Elev. 1874'

REPORT

6/25

Spud 6-18-52

8" @ 290'

Drlg. 2226'

7/2

Topeka 2759 Heeb. 2987 Lans. 3037

Arb. 3309 RTD 3312 5" @ 3310

7/9

DD 3323 1 galoph 500 A

7/16

Spud 6-18-52

D & A TD 3330' 8" @ 290

Top. 2759' Heeb 2987' Lans. 3037'

Arb. 3309' TD 3312' 5" @ 3310'

DD 3323' 1 GOPH 500 A DD 3325'

FU 1450' fluid 14 hr. mostly water.

S/4 BFPH DD 3330' D & A

ABANDONED

