

KANSAS

Map No. _____ Sec. 31 Twp. 13 R. 14-W

Well No. 1-Brown Farm _____


Shell Pet. _____ Company _____

330 Ft. from N. Line

_____ Ft. from S. Line

330 Ft. from E. Line

_____ Ft. from W. Line

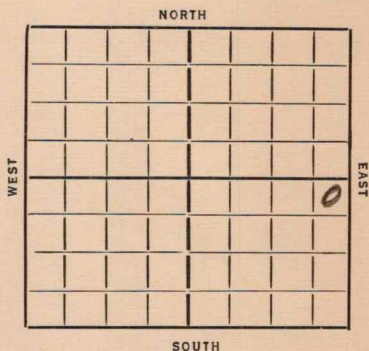

Elev. 1868

Date
1936

REPORT

4/8 Location

4/16 Rigging up.

4/23 Drlg. 385'.

4/30 --

5/7 Drlg. 390'

5/14 15" @ 333'-10" @ 940' Drlg.

5/21 Drlg. 1205'.

5/28 Drlg. 2270'.

6/4 Topeka 2758'. Drlg. ~~2875'~~ 2765'.

6/11 Lansing 3030(7" @ 3034'. Show oil and water 3135'-40'. Drlg. 3157'.

7/1/36-Sil. 3301'.

T.D. 3317'.

1,000 gallons acid.

526 bbls of oil and 520 bbls of water.

COMPLETED

Map No. 72 Sec. 31 Twp. 13 R. 14W

Well No. Brown

Shell Oil Co Company

Contractor

SECTION PLAT

330 Ft. from N. Line

..... Ft. from S. Line

330 Ft. from E. Line

..... Ft. from W. Line

			o

FIRST REPORT

Location ✓

Rig up

Drilling and Remarks:

RECORD

Cased..... in., ft.

Sand

Gas

Oil

Total Depth.....

PRODUCTION

1st 24 hrs. Nat.....

1st 24 hrs. after shot.....

Gas..... Cu. Ft.

Dry Hole.....

Abandoned.....

Date

4/8/36

192.....

S. J. LEWIS

Scout

Map No. 72 Sec. 31 Twp. 13 R. 14W

Well No. 1 Brown

Shell Company

Contractor

SECTION PLAT

			0

330 Ft. from N. Line

_____ Ft. from S. Line

330 Ft. from E. Line

_____ Ft. from W. Line

COMPLETED

Location _____

Rig up _____

Drilling and Remarks:

Sil 3301

1000 acid

526 Oil

520 Water

RECORD

Cased _____ in., _____ ft.

Sand _____

Gas _____

Oil _____

Total Depth 3317

PRODUCTION

1st 24 hrs. Nat. _____

1st 24 hrs. after shot _____

Gas _____ Cu. Ft.

Dry Hole _____

Abandoned _____

Date

JUL 1 1936 19

S. J. LEWIS Scout