


Russell

Form 51-5M-11-38-Palace

Section 31 Township 13 Range 14-W

Well No. 1 Brown

Company Johnson & Clink

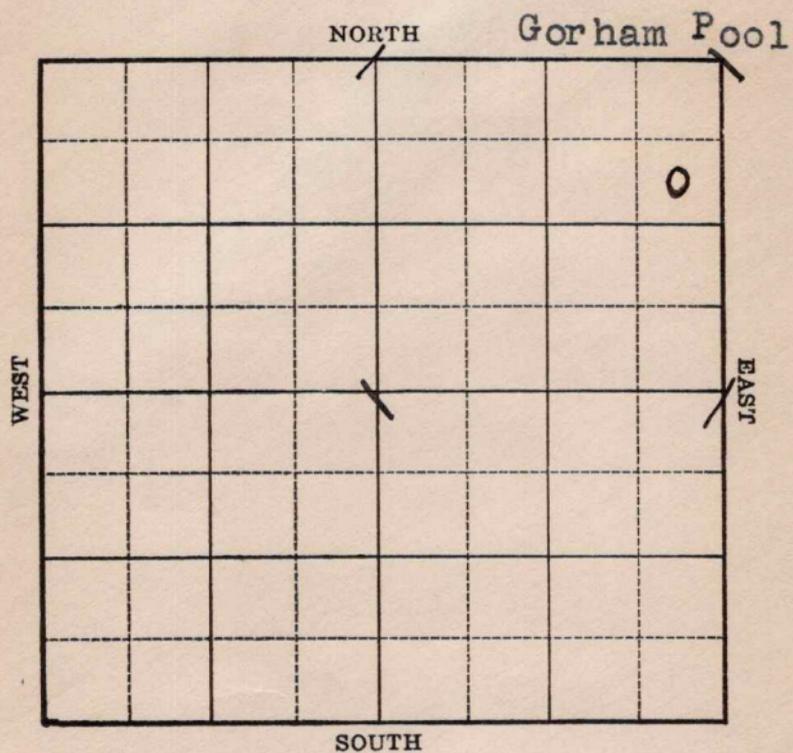

Sec. 31 Twp. 13 R. 14-W

Well No. #1 Brown Farm

Johnson & Clink Company


(Gorham)

990 Ft. from N. Line

\_\_\_\_\_ Ft. from S. Line

330 Ft. from E. Line

\_\_\_\_\_ Ft. from W. Line

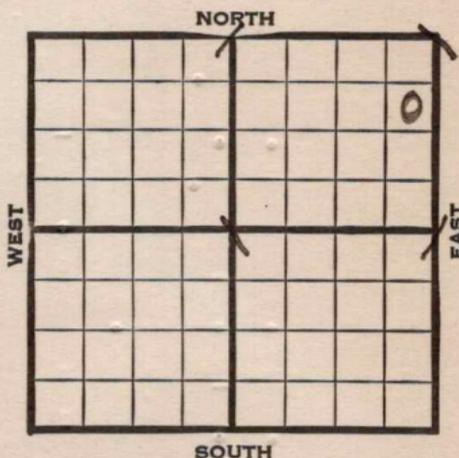

1939	REPORT
5/10	R. U. Cable Rig.
5/19	Spud & SD.
5/26	" "
6/7	" "
6/8	" "
6/16	" "
6/23	" "
6/29	" "
7/6	" "
7/13	" "
7/20	" "
7/27	" "
8/3	" "
8/10	" "
8/17	Spud 50'
8/24	15" - 335' T.D. 387' SD for repairs.
8/31	10" - 570' Drlg. 825'
9/7	Anhy 920' 10" - 931' Drlg. 1220'
9/14	Drlg. 2075'

**OVER**

- 1939
- 9/21 Drlg. 2565'
- 9/28 **Topoka 2715'** 8" - 27 20'  
Drlg. 2728'
- 10/5 S.O. 2830-35' 2 BW 2945-50'  
**Lans. 3026'** 7" - 30 30' TD.  
Shut down.
- 10/12 7" - 3061' T.D. 3094'  
U.R. 7".
- 10/19 7" - 3160' **Arb. 3311'**  
S.O. 3325' S.W. 3329'  
Drlg. 3330'
- 10/26 5" - <sup>3311</sup>~~3323~~' T.D. 3330'  
Bailing & C.O.
- 11/2 **Arb. 3311' (Corrected)**  
5" - 3311' C.O.
- 11/9 T.D. 3323' Drilled plug.  
1000' oil, no time given.  
P.B.P. Run tubing.
- 11/16 70 gals. acid.  
Pump 50 bbls. oil 3 hours.
- 11/22 **Arb. 3311'**  
5" - 3311'  
70 gals. acid.  
T.D. 3323'  
Pump 105 oil & 105 water.

**COMPLETED**

Map No. \_\_\_\_\_ Sec. **31** Twp. **13** R. **14W**

Well No. **1 Brown**

**Johnson & Clink** Company

Contractor

**FIRST REPORT**

**SE NE NE**


**990** Ft. from N. Line

\_\_\_\_\_ Ft. from S. Line

**330** Ft. from E. Line

\_\_\_\_\_ Ft. from W. Line

**SECTION PLAT**

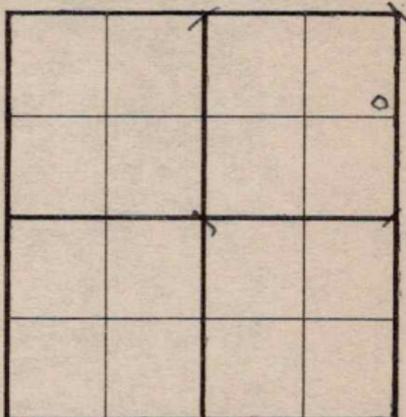

**GORHAM POOL**

Location \_\_\_\_\_

Rig up \_\_\_\_\_

Drilling and Remarks:  
**R.U. Cable Rig.**

**RECORD**

Cased \_\_\_\_\_ in., \_\_\_\_\_ ft.

Sand \_\_\_\_\_

Gas \_\_\_\_\_

Oil \_\_\_\_\_

Total Depth \_\_\_\_\_

**PRODUCTION**

1st 24 hrs. Nat. \_\_\_\_\_

1st 24 hrs. after shot \_\_\_\_\_

Gas \_\_\_\_\_ Cu. Ft.

Dry Hole \_\_\_\_\_

Abandoned \_\_\_\_\_

Date

MAY 10 1939 19

**S. J. LEWIS**

Scout

Map No. 72 Sec. 31 Twp. 13 R. 14W

Well No. 1 Brown

Johnson & Clink

Company

Contractor

COMPLETED

SE NE NE

990 Ft. from N. Line

\_\_\_\_\_ Ft. from S. Line

330 Ft. from E. Line

\_\_\_\_\_ Ft. from W. Line

GORHAM POOL

SECTION PLAT


Location \_\_\_\_\_

Rig up \_\_\_\_\_

Drilling and Remarks:

*Cu 83311*  
*5" C 3311*  
*70 gal acid*  
*Pump 105 oil*  
*105 water*

RECORD

Cased \_\_\_\_\_ in., \_\_\_\_\_ ft.

Sand \_\_\_\_\_

Gas \_\_\_\_\_

Oil \_\_\_\_\_

Total Depth 3323

PRODUCTION

1st 24 hrs. Nat. \_\_\_\_\_

1st 24 hrs. after shot \_\_\_\_\_

Gas \_\_\_\_\_ Cu. Ft.

Dry Hole \_\_\_\_\_

Abandoned \_\_\_\_\_

Date

NOV 22 1939 19

S. J. LEWIS

Scout