

Ellis

KANSAS


SEC. 27 TWP. 14 R. 16 W

WELL NO. # 2 Berens FARM

COMPANY Transit Corp.

CONTRACTOR Transit

SE Dreiling Pool  
 990 Ft. from N. Line  
 Ft. from S. Line  
 330 Ft. from E. Line  
 Ft. from W. Line

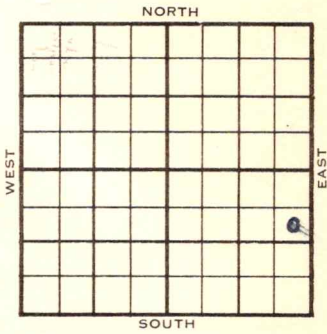

SE NE SE

Atl. support

	ELEVATION	REPORT
1953	1835'	

9/30	Spud 9-28-53 8" @ 934' Anhy 925'	
10/7	Drlg. 1850' Heeb 3032' Tor 3052' DST 3039-70' 1 hr, 12' M 975# 15" Lans 3076' DST 3080-94'	
10/14	1 hr., 118' socm, 40# DST 3118-40, 1 hr., 80' ocm DST 3234-72, 1 hr., 6' M, 15# Rew Arb 3358 Arb. 3362' RTD 3367 5" @ 3362'	
10/21	CO 3368' 500 A S/6 BOPH	
10/28	NR	
11/4	NR	
11/11	P/116 B0 22 hrs.	
11/18	Spud 9-28-53 Oil Well TD 3368' 8" @ 934'	

Anhy 925', Heeb 3032', Tor 3052'

OVER

1953

Information brought forward.

11/18

DST 3039'-70' opn 1 hr, rec 12' Mud  
975# **Lans 3076'**

DST 3080'-3118' opn 1 hr, rec 118'  
socm 40#

DST 3118'-40' opn 1 hr, rec 80' ocm

DST 3234'-72' opn 1 hr, rec 6' Mud  
15# **ReArb 3358', Arb 3362'**

TD 3367'

5" @ 3362'

CO to 3368

500 A <sup>S</sup>/ 6 boph P/ 116 bo 22 hr.

Comp 162 bopd.

**COMPLETED**

County **Ellis** State **Kansas**

Sec. **27** (Blk. Twp.) **14** (Sur. Rge.) **16W** Map No.

Operator **Transit Corp.**

Well No. **2** Farm **Berens**

Elev. Location **SE NE SE**


**990** Ft. From **N** Line **SE**

**330** Ft. From **E** Line Quarter

1st. Report **SEP 30 1953**

Completion

Remarks **Atl. - support**  
**Transit - Contr.**

Spudding Date **9-28-53**

Drlg. Data **SE Dreiling Pool**

**8" @ 934 Anhy925 drlg. 1850**

