


Section 31 Township 13 Range 11W

Well No. 2 Brown

Company Kim Oil

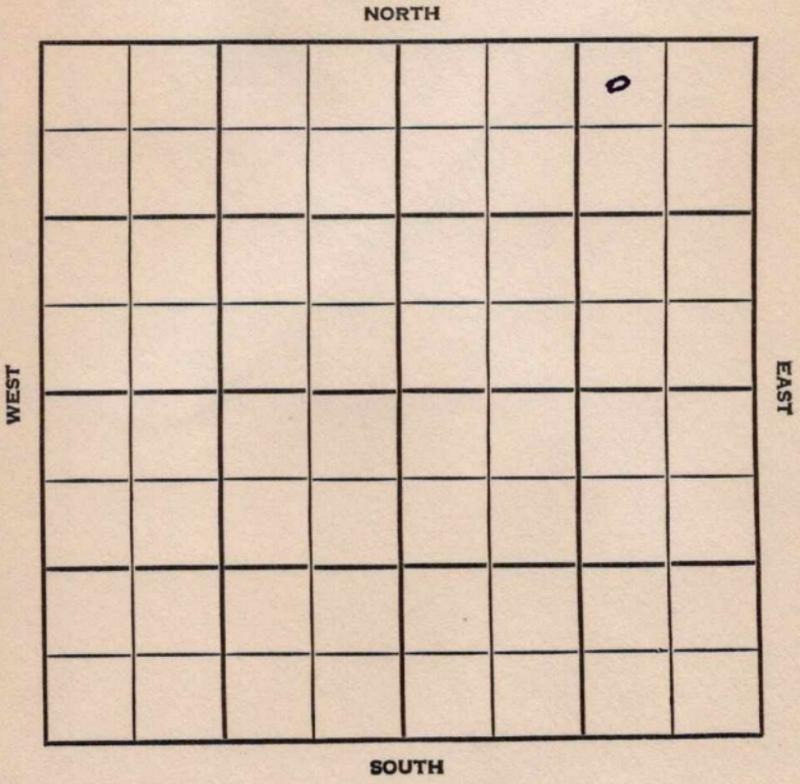

Russell

KANSAS

| | | |
|------|------|-------|
| SEC. | TWP. | R. |
| 31 | 13 | 14W ✓ |


WELL NO. #2 Brown FARM

COMPANY Kim Oil

CONTRACTOR Sidey

atherton Pool

330 Ft. from N. Line
 Ft. from S. Line
 990 Ft. from E. Line
 Ft. from W. Line

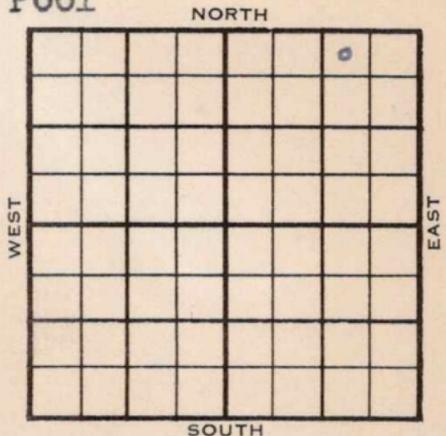

NW NE NE

| | | |
|------|-----------|--------|
| | ELEVATION | REPORT |
| 1954 | 1873' | |

5/26 Spud 5-21-54
 8" @ 196'
 Drlg 2300'

6/2 RTD 3314' 5" @ 3314

6/9 WOCT

6/15 Spud 5-21-54 - Oil Well
 TD 3321'
 8" @ 196'
 Arb. 3313'
 TD 3314'
 5" @ 3314'
 DD 3321' 500A, 3 boph
 Comp. 25 bopd

COMPLETED

