


*Kansas*

Map No. \_\_\_\_\_ Sec. *31* Twp. *21* R. *10*

Well No. *3 a ateyes* Farm \_\_\_\_\_

*Transcontinental Oil* Company

NORTH

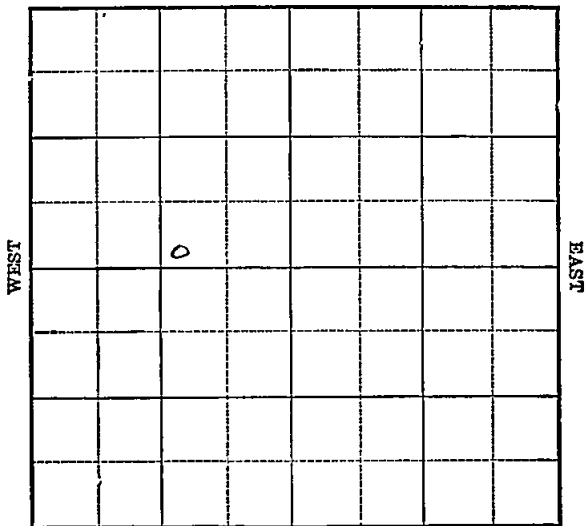

SOUTH

Location \_\_\_\_\_

Drilling Remarks \_\_\_\_\_  
\_\_\_\_\_  
\_\_\_\_\_  
Rig Up \_\_\_\_\_

Drilling Remarks \_\_\_\_\_  
\_\_\_\_\_  
\_\_\_\_\_  
**RECORD**

Cased \_\_\_\_\_ in. \_\_\_\_\_ ft.

Sand \_\_\_\_\_

Gas \_\_\_\_\_

Oil \_\_\_\_\_

Total Depth \_\_\_\_\_

**PRODUCTION**

1st 24 hrs. Nat. \_\_\_\_\_

1st 24 hrs. after shot \_\_\_\_\_

Gas \_\_\_\_\_ cu. ft.

Dry Hole \_\_\_\_\_

Abandoned \_\_\_\_\_

Map No. Kanear Sec. 31 Twp. 2 R. 10


Well No. 3<sup>A</sup> aty 10 Farm  
Transcontinental Company

..... Ft. from N. Line

330 Ft. from S. Line

990 Ft. from E. Line

..... Ft. from W. Line

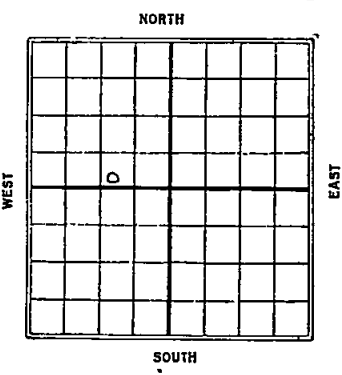

1926.

Date REPORT

5/5 Rign up

5/8 Stop 2250

5/12 Rign up.

5/19 Spudding

5/12 Wrlg. 1755

6/10 Top sand 2090-2151  
filled up 1000' natural  
shot 80 gts. C. O.

6/17 sand 2090-2151 80 gts  
45 bbls



Map No. **K21 KANSAS** Sec. **31** Twp. **21** R. **10**

Well No. **2 C** **Atypo**

**Iron Acorten 8al oil** Company

Contractor

SECTION PLAT

\_\_\_\_\_ Ft. from N. Line

**330** Ft. from S. Line

**990** Ft. from E. Line

\_\_\_\_\_ Ft. from W. Line

	o		

FIRST REPORTS

Location \_\_\_\_\_

Rig up

Drilling and Remarks:

RECORD

Cased \_\_\_\_\_ in., \_\_\_\_\_ ft.

Sand \_\_\_\_\_

Gas \_\_\_\_\_

Oil \_\_\_\_\_

Total Depth \_\_\_\_\_

PRODUCTION

1st 24 hrs. Nat. \_\_\_\_\_

1st 24 hrs. after shot \_\_\_\_\_

Gas \_\_\_\_\_ Cu. Ft.

Dry Hole \_\_\_\_\_

Abandoned \_\_\_\_\_

Date

MAY 5 1926

192

CHAS. L. SHERWOOD

Scout

*Hyon*

Map No. *K21* KANSAS Sec. *31* Twp. *21* R. *10*

Well No. *39* *atyeo*

*Transcontinental* Company

Contractor

COMPLETED

SECTION PLAT

----- Ft. from N. Line

*330* Ft. from S. Line

*990* Ft. from E. Line

----- Ft. from W. Line


Location -----

Rig up -----

Drilling and Remarks:

*807 45 lbs.*

RECORD

Cased ----- in., ----- ft.

Sand *2090-2151'*

Gas -----

Oil -----

Total Depth *2151'*

PRODUCTION

1st 24 hrs. Nat. -----

1st 24 hrs. after shot -----

Gas ----- Cu. Ft.

Dry Hole -----

Abandoned -----

Date

JUN 17 1926

CHAS. L. SHERWOOD,