

KANSAS


Cowley

Form 51-5M-7-39-Palace

Section 19 Township 30 Range 5-E

Well No. #1 Russell

Company Hawkeye

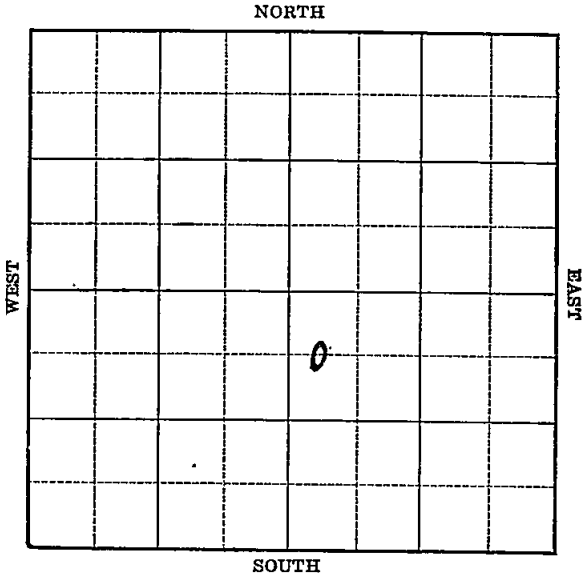

Sec. 19 Twp. 30 R. 5-E

Well No. #1 Russell Farm

Hawkeye Company


660 Ft. from N. Line

_____ Ft. from S. Line

_____ Ft. from E. Line

330 Ft. from W. Line

Elev. 1297

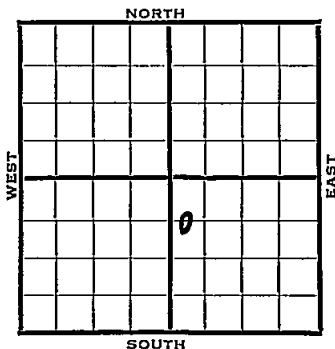

1940	REPORT
4/10	Location
4/18	Derrick.
4/25	10" - 72' WOC.
5/2	K.C. 2267' Drlg. 2697'
5/8	Arb. 3377'
	Total depth 3396'
	Water. ABANDONED

Map No. 11 Sec. 19 Twp. 30 R. 5E

Well No. 1 Russell

Hawkeye Company

Contractor

FIRST REPORT

C W L NW SE

660 Ft. from N. Line

_____ Ft. from S. Line

_____ Ft. from E. Line

330 Ft. from W. Line

SECTION PLAT

		o	

Location X

Rig up _____

Drilling and Remarks:

RECORD

Cased _____ in., _____ ft.

Sand _____

Gas _____

Oil _____

Total Depth _____

PRODUCTION

1st 24 hrs. Nat. _____

1st 24 hrs. after shot _____

Gas _____ Cu. Ft.

Dry Hole _____

Abandoned _____

Date

APR 10 1940 19

S. J. LEWIS Scout

Map No. 11 Sec. 19 Twp. 30 R. 5EWell No. 1 RussellHawkeye

Company

Contractor

ABANDONED

SECTION PLAT

		o	

C W L NW SE

660 Ft. from N. Line

_____ Ft. from S. Line

_____ Ft. from E. Line

330 Ft. from W. Line

Location _____

Rig up _____

Drilling and Remarks:

*Cr 83377**Water*

RECORD

Cased _____ in., _____ ft.

Sand _____

Gas _____

Oil _____

Total Depth 3376

PRODUCTION

1st 24 hrs. Nat. _____

1st 24 hrs. after shot _____

Gas _____ Cu. Ft.

Dry Hole _____

Abandoned _____

Date

MAY 8 1940 19S. J. LEWIS Scout