

Map No. Butler **KANSAS** Sec. 33 Twp. 28^S R. 4^E

Well No. 2 - Purcell Farm
German American Company

NORTH

				0			

WEST

EAST

SOUTH

Location.....

Drilling Remarks

Rig Up.....

Drilling Remarks

RECORD

Cased..... in..... ft.

Sand.....

Gas.....

Oil.....

Total Depth.....

PRODUCTION

1st 24 hrs. Nat.....

1st 24 hrs. after shot.....

Gas..... cu. ft.....

Dry Hole.....

Abandoned.....

Map No. Sec. Twp. R.

Well No. Farm


..... Company

..... Ft. from N. Line

..... Ft. from S. Line

..... Ft. from E. Line

..... Ft. from W. Line

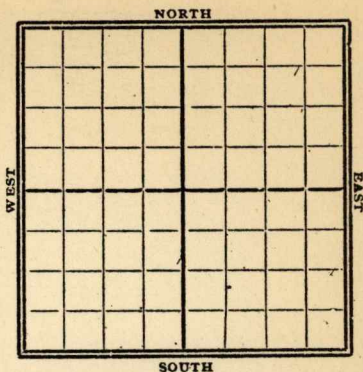

1917

Date

REPORT

Gypsy Records

1/24

Abd T.D. 2670'

K11 MAP NO. KANSAS SEC. 33 TWP. 28S R. 4E
WELL NO. 2 Purcell
German American COMPANY

CONTRACTOR

SECTION PLAT

ABANDONED

		0	

_____ FT. FROM N. LINE
_____ FT. FROM S. LINE
_____ FT. FROM E. LINE
_____ FT. FROM W. LINE

RECORD

LOCATION _____
RIG UP _____
DRILLING AND REMARKS:

CASED _____ IN. _____ FT.
SAND _____
GAS _____
OIL _____
TOTAL DEPTH 7670

PRODUCTION

1ST 24 HRS. NAT. _____
1ST 24 HRS. AFTER SHOT _____
GAS _____ CU. FT.
DRY HOLE ✓
ABANDONED ✓

DATE

1-24 19217 SCOUT