


Section 30 Township 28 Range 4-E

Well No. #1 Mackay

Company R. W. Holcomb et al.

Miscellaneous

NORTH

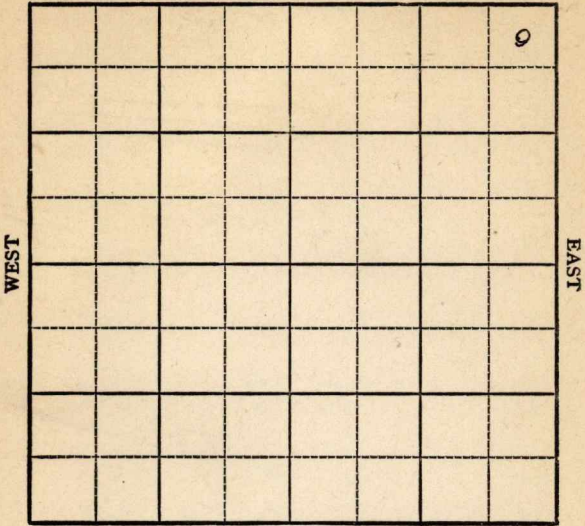

SOUTH

Butler

KANSAS

Sec. 30 Twp. 28 R. 4E ✓

Well No. #1 Mackay Farm

R. W. Holcomb et al

Company

Miscellaneous


330' Ft. from N. Line

Ft. from S. Line

330' Ft. from E. Line

Ft. from W. Line

NE/C

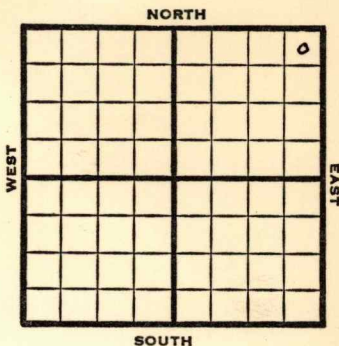

1948

Elev. 1266' REPORT

12/1

8" @ 78'  
Drlg. 600'

12/6

KC 2042'  
Drlg. 2377'

12/14

Arbuckle 2457'  
5" @ 2454'  
TD 2460'  
HFO

12/22

Arb 2457'  
5" @ 2454'  
Pump 50 oil Pot.  
Gr. 38°  
TD 2460'

COMPLETED

Map No. \_\_\_\_\_ Sec. 30 Twp. 28 R. 4E

Well No. 1 Mackay

R. W. Holcomb et al. Company

FIRST REPORT Contractor

NE/C

SECTION PLAT

330 Ft. from N. Line

\_\_\_\_\_ Ft. from S. Line

330 Ft. from E. Line

\_\_\_\_\_ Ft. from W. Line

				o

Butler County

Location \_\_\_\_\_

Rig up \_\_\_\_\_

Drilling and Remarks:

8" @ 78

drlg. 600

RECORD

Cased \_\_\_\_\_ in., \_\_\_\_\_ ft.

Sand \_\_\_\_\_

Gas \_\_\_\_\_

Oil \_\_\_\_\_

Total Depth \_\_\_\_\_

PRODUCTION

1st 24 hrs. Nat. \_\_\_\_\_

1st 24 hrs. after shot \_\_\_\_\_

Gas \_\_\_\_\_ Cu. Ft.

Dry Hole \_\_\_\_\_

Abandoned \_\_\_\_\_

Date

DEC 1 1948

19

S. J. LEWIS

Scout

Map No. 11 Sec. 30 Twp. 28 R. 4E

Well No. 1 Mackay

R. W. Holcomb et al. Company

COMPLETE Contractor

NE/C

E11266  
SECTION PLAT

330 Ft. from N. Line

\_\_\_\_\_ Ft. from S. Line

330 Ft. from E. Line

\_\_\_\_\_ Ft. from W. Line

			o

Butler County

Location \_\_\_\_\_

Rig up \_\_\_\_\_

Drilling and Remarks:

22457

5110243-4

Pump soil

382

RECORD

Cased \_\_\_\_\_ in., \_\_\_\_\_ ft.

Sand \_\_\_\_\_

Gas \_\_\_\_\_

Oil  \_\_\_\_\_

Total Depth 2460

PRODUCTION

1st 24 hrs. Nat. \_\_\_\_\_

1st 24 hrs. after shot \_\_\_\_\_

Gas \_\_\_\_\_ Cu. Ft.

Dry Hole \_\_\_\_\_

Abandoned \_\_\_\_\_

Date

DEC 22 1948 19

S. J. LEWIS

Scout