


Cowley

KANSAS

Section 24 Township 30 Range 5E

Well No. 1 Bice

Company Pryor & Lockhart et al

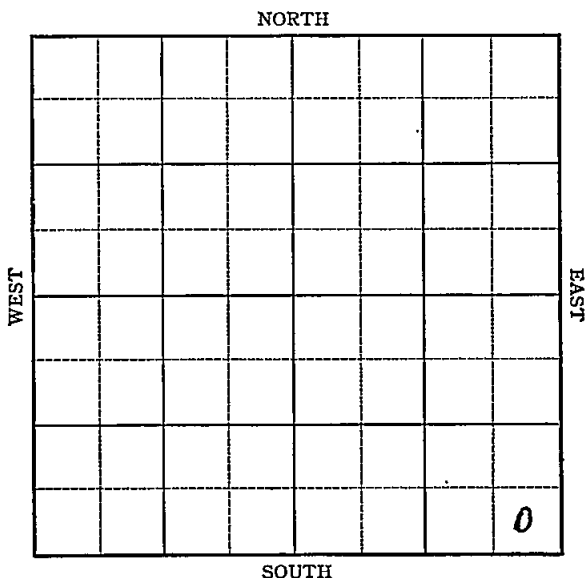


Sec. 24 Twp. 30 R. 5-EWell No. #1 Bice FarmPryor & Lockhart et al Company

(Couch)

 Ft. from N. Line330 Ft. from S. Line330 Ft. from E. Line Ft. from W. Line

Elev. 1367

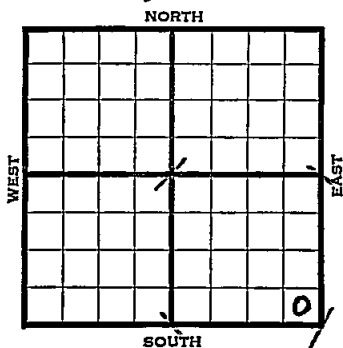

1941	REPORT
6/18	Mach.ine.
6/26	"
7/3	"
7/10	"
7/17	"
7/24	"
7/31	Spud 115'
8/7	12" @ 247' Drlg. 780'
8/15	Dlg. 1209
8/21	Drlg. 1388'
8/28	10" - 1461' Lens. 1685'
	T.D. 1800' SD. HFW 1878-89'
9/4	8" - 2080' Drlg. 2385'
9/11	K.C. 2230' 6" - 2580'
	Drlg. 2680'
	OVER

1941
9/17

Bart. 2835'

Miss. 2987'

T.D. 2987'

Water.


ABANDONED

Map No. 11 Sec. 24 Twp. 30 R. 5EWell No. 1 BicePryor & Lockhart etal CompanyFIRST REPORT Contractor

SE/C

 Ft. from N. Line330 Ft. from S. Line330 Ft. from E. Line Ft. from W. Line

SECTION PLAT.

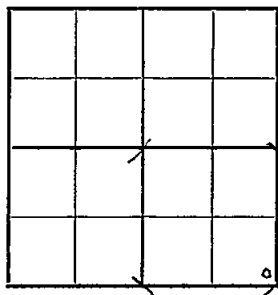

COUCH POOL

RECORD

Location Rig up

Drilling and Remarks:

Machine

Cased in., ft.Sand Gas Oil Total Depth

PRODUCTION

1st 24 hrs. Nat. 1st 24 hrs. after shot Gas Cu. Ft.Dry Hole Abandoned

Date

JUN 1 8 10/11 19S. J. LEWIS Scout

Map No. 11 Sec. 24 Twp. 30 R. 5EWell No. 1 BicePryor & Lockhart et al Company**ABANDONED**

Contractor

SE/C

SECTION PLAT

 Ft. from N. Line330 Ft. from S. Line330 Ft. from E. Line Ft. from W. Line

COUCH POOL

RECORD

Location Cased in., ft.Rig up Sand

Drilling and Remarks:

Gas Oil Total Depth 2987

PRODUCTION

1st 24 hrs. Nat. 1st 24 hrs. after shot Gas Cu. Ft.Dry Hole Abandoned *Bar Y 2835**Miss 2987**Water.*

Date

SEP 17 1941

19

S. J. LEWIS

Sec