


Section 31 Township 13 Range 14W

Well No. 4 Brown

Company Murfin Drlg.

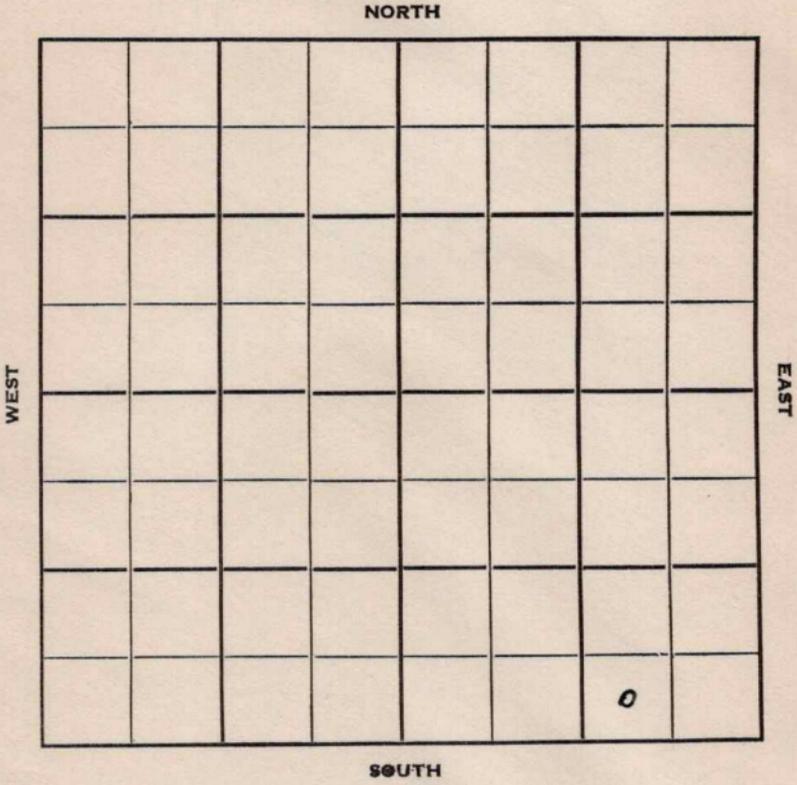

Russell

KANSAS

Sec. 31 Twp. 13 R. 14 W

Well No. # 4 Brown Farm _____

Murfin Drlg. Company _____

Contractor _____


_____ Ft. from N. Line

330 Ft. from S. Line

990 Ft. from E. Line

_____ Ft. from W. Line

SW SE SE

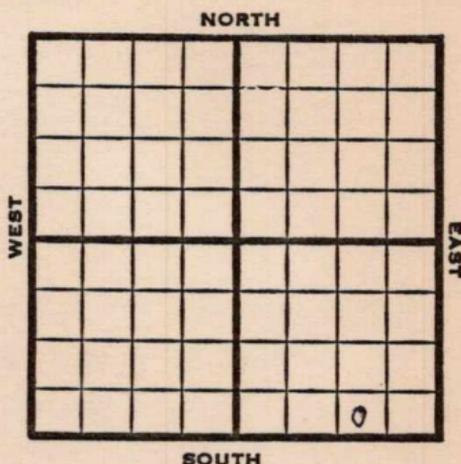

1951 **Elev. 1858'** REPORT

7/18
8/15

R U R
 Spud 7-17-51
 SWD well TD 3457'
 8" @ 535' Anhy 900' Tarkio 2458'
 Top. 2758' Heeb 2978' Lans. 3030'
 Granite 3457' TD 5" @ 3370'
 Cong. 3301' Arb. 3311' 1000 A
 Comp. for SWD well
 Input 3 BSW per min.

ABANDONED

