


Map No. _____ Sec. 34 Twp. 28 R. 4Well No. 1 Thompson Farm _____
Hercules Oil Company _____

NORTH

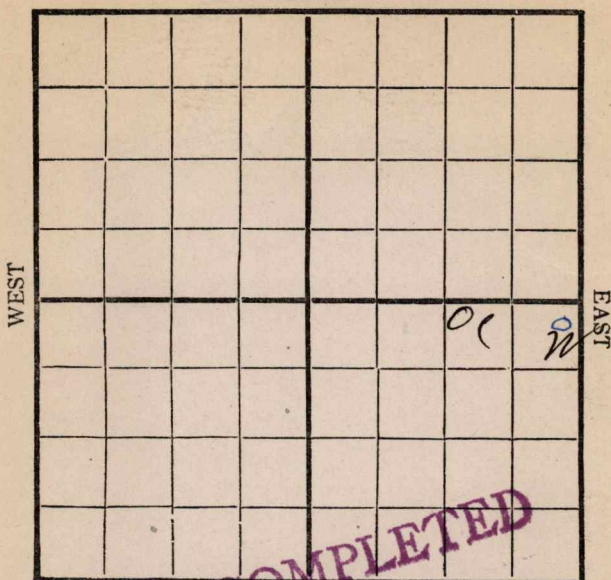

SOUTH

Location _____

Rig Up 1-8-17

Drilling Remarks:

Drilling Remarks:

R. U. 1/15:

RECORD

PRODUCTION

Cased _____ in _____ Ft.

1st 24 hrs. Nat. _____

Sand _____

1st 24 hrs. after shot _____

Gas _____

Gas _____ Cu. Ft.

Oil _____


Dry Hole _____

Total Depth _____

Abandoned _____

Map No. _____ Sec. 34 Twp. 28 R. 4Well No. 1 Thompson Farm _____Hercules oil Company _____

NORTH

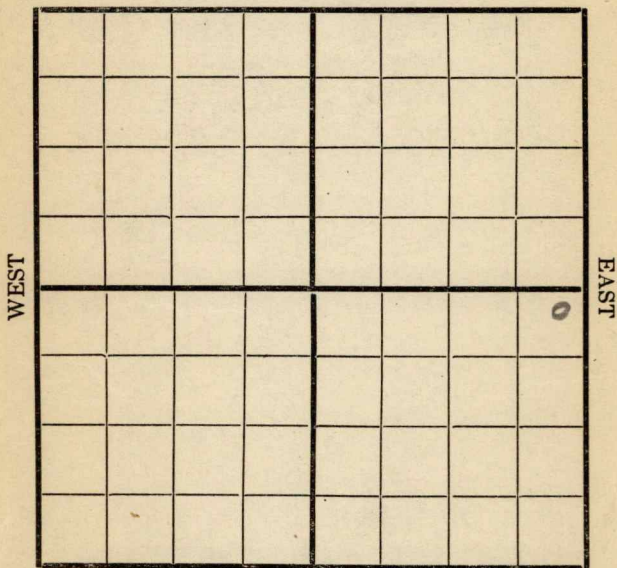

SOUTH

Location _____

Rig Up _____

Drilling and remarks _____

*New
Location*

RECORD

Cased _____ in. _____ Ft.

Sand _____

Gas _____

Oil _____

Total Depth _____

PRODUCTION

1st 24 hrs. Nat. _____

1st 24 hrs. after shot _____

Gas _____ Cu. Ft.

Dry Hole _____

Abandoned _____


Date _____

1/8, 1917 _____ Scout

Map No. _____ Sec. 34 Twp. 28 R. 4
 Well No. Thompson Farm
Hersules Oil Company

NORTH

WEST

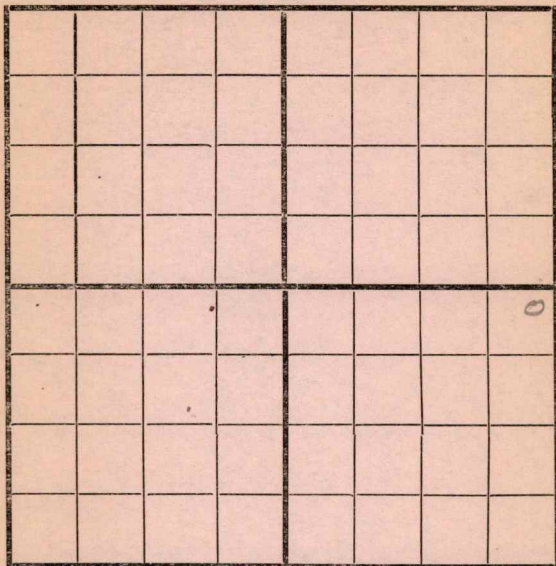

EAST

SOUTH

Location _____
 Rig Up ☒ _____
 Drilling and remarks _____

RECORD

Cased _____ in. _____ Ft.
 Sand _____
 Gas _____
 Oil _____
 Total Depth _____

PRODUCTION

1st 24 hrs. Nat. _____
 1st 24 hrs. after shot _____
 Gas _____ Cu. Ft.
 Dry Hole _____
 Abandoned _____


Date

1/32, 1917 Condy Scout

Map No. _____ Sec. 34 Twp. 28 R. 4
 Well No. 1 Thompson Farm _____
Hess & Co. Oil Company _____

NORTH

WEST

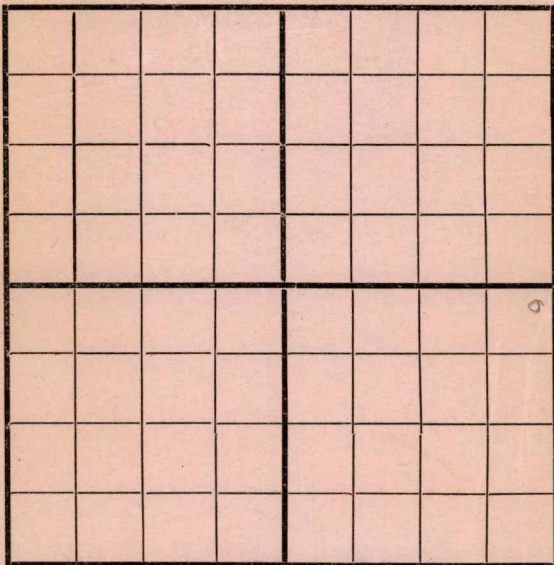

EAST

SOUTH

Location _____

Rig Up _____

Drilling and remarks _____

RECORD

Cased _____ in. _____ Ft.

Sand _____

Gas _____

Oil _____

Total Depth _____

PRODUCTION

1st 24 hrs. Nat. _____

1st 24 hrs. after shot _____

Gas _____ Cu. Ft.

Dry Hole _____

Abandoned _____

Date _____


1/29, 1917 Candy Scout

Map No. _____ Sec. 34 Twp. 28 R. 4Well No. 1 Thompson Farm _____Shawles Company _____

NORTH

WEST

EAST

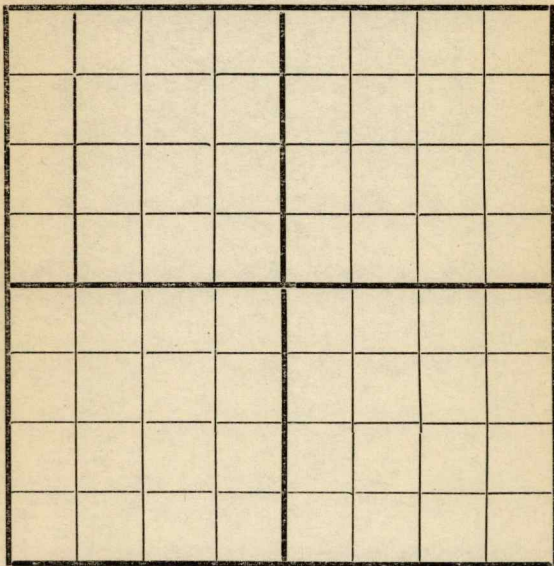

SOUTH

Location ✓Rig Up ✓

Drilling and remarks

RECORD

Cased _____ in. _____ Ft.

Sand _____

Gas _____

Oil _____

Total Depth _____

PRODUCTION

1st 24 hrs. Nat. _____

1st 24 hrs. after shot _____

Gas _____ Cu. Ft.

Dry Hole _____


Abandoned _____

Date

2/5, 1917 Condy Scout

Map No. _____ Sec. 34 Twp. 28 R. 4Well No. 1 Thompson Farm _____Hercules oil Company _____

NORTH

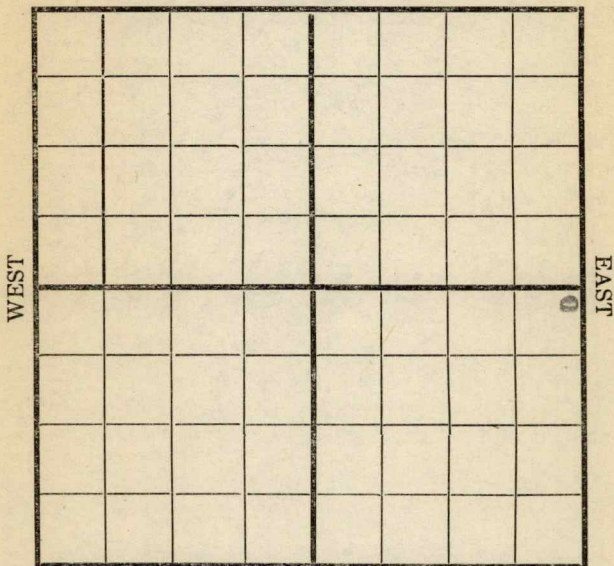

SOUTH

Location _____

Rig Up _____

Drilling and remarks _____

RECORD

Cased _____ in. _____ Ft.

Sand _____

Gas _____

Oil _____

Total Depth _____

PRODUCTION

1st 24 hrs. Nat. _____

1st 24 hrs. after shot _____

Gas _____ Cu. Ft.

Dry Hole _____

Abandoned _____


Date _____

2/2 191 2 early Scout

Map No. _____ Sec. 34 Twp. 28 R. 4Well No. 19 Thompson Farm _____Hercules Company _____

NORTH

WEST

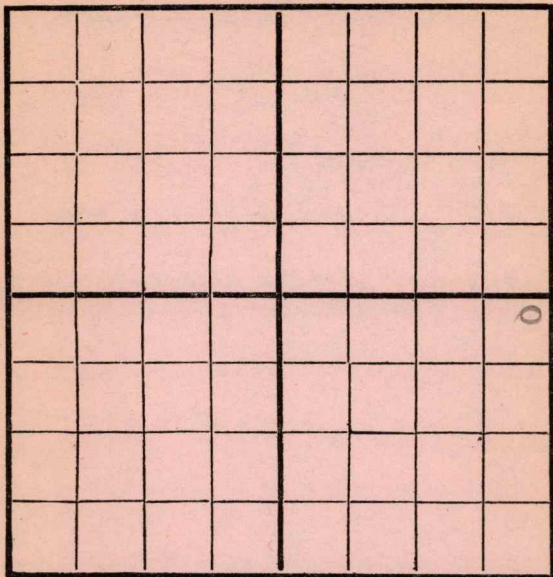

EAST

SOUTH

Location _____

Rig Up _____

Drilling and remarks _____

RECORD

Cased _____ in. _____ Ft.

Sand _____

Gas _____

Oil _____

Total Depth _____

PRODUCTION

1st 24 hrs. Nat. _____

1st 24 hrs. after shot _____

Gas _____ Cu. Ft.

Dry Hole _____

Abandoned _____


Date

2/19, 1917 Cardiff

Scout

Map No. _____ Sec. 34 Twp. 28 R. 4
 Well No. 19 Thompson Farm _____
Merced Company _____

NORTH

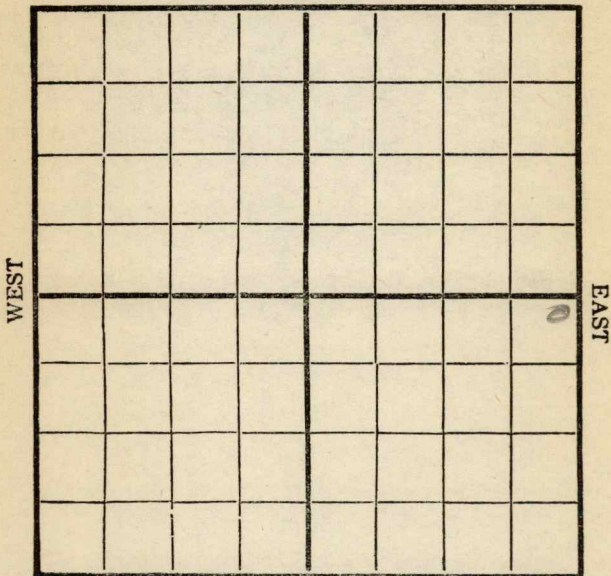

SOUTH

Location _____
 Rig Up _____
 Drilling and remarks _____

RECORD

Cased _____ in. _____ Ft.
 Sand _____
 Gas _____
 Oil _____
 Total Depth _____

PRODUCTION


1st 24 hrs. Nat. _____
 First 24 hrs. after shot _____
 Gas _____ Cu. Ft.
 Dry Hole _____
 Abandoned _____

Date

2/26, 1917 C. Condy Scout

Map No. _____ Sec. 34 Twp. 28 R. 4Well No. 1 Thompson FarmHerrell Company

NORTH

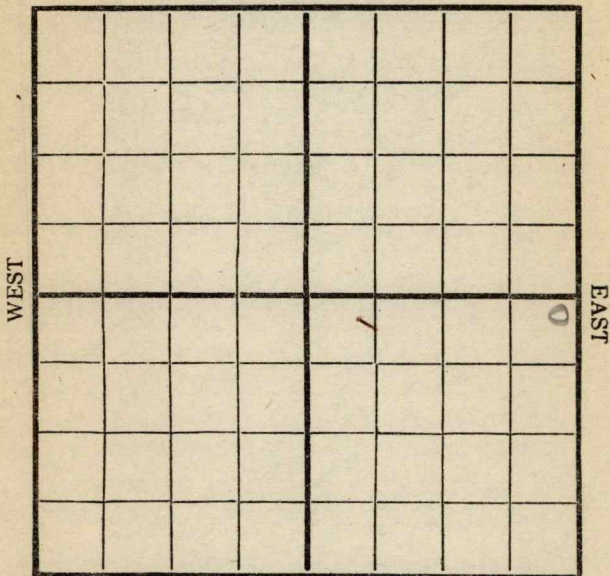

SOUTH

REMARKS:

Rig


Date

3/5-7, 1917Cordell Scout

Map No. _____ Sec. 34 Twp. 28 R. 4
 Well No. 19 Thompson Farm
Heard Company

NORTH

WEST

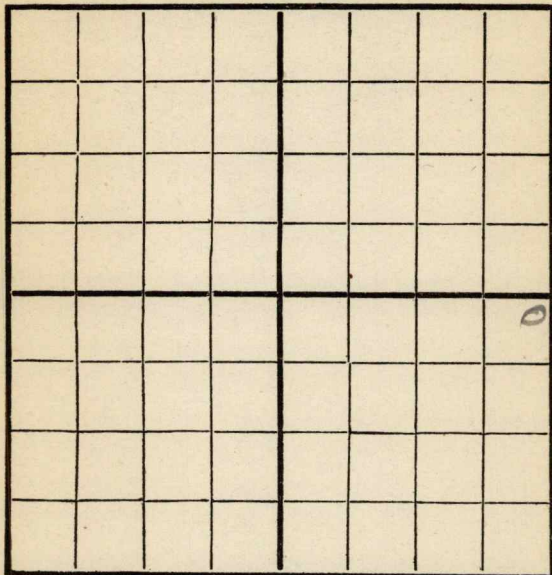

EAST

SOUTH

Location _____
 Rig Up _____
 Drilling and remarks _____

RECORD

Cased _____ in. _____ Ft.
 Sand _____
 Gas _____
 Oil _____
 Total Depth _____

PRODUCTION

1st 24 hrs. Nat. _____
 1st 24 hrs. after shot _____
 Gas _____ Cu. Ft.
 Dry Hole _____
 Abandoned _____

Date

3/12, 1912 Conley Scout

Map No. _____ Sec. _____ Twp. _____ R. _____

Well No. 1. Thompson Farm

Heinrich _____ Company

NORTH

WEST

EAST

SOUTH

Location _____

Rig Up-----

Drilling and remarks

RECORD

Cased_____in. _____Ft.

Sand _____

Gas _____

Oil_____

Total Depth-----

PRODUCTION

1st 24 hrs. Nat. _____

1st 24 hrs. after shot-----

Gas_____Cu. Ft.

Dry Hole.....

Abandoned_ _ _ _ _


Date _____

319 1917. *Carl* Scout

Map No. _____ Sec. 34 Twp. 28 R. 4Well No. 17 Thompson Farm _____Heracles Company _____

NORTH

WEST

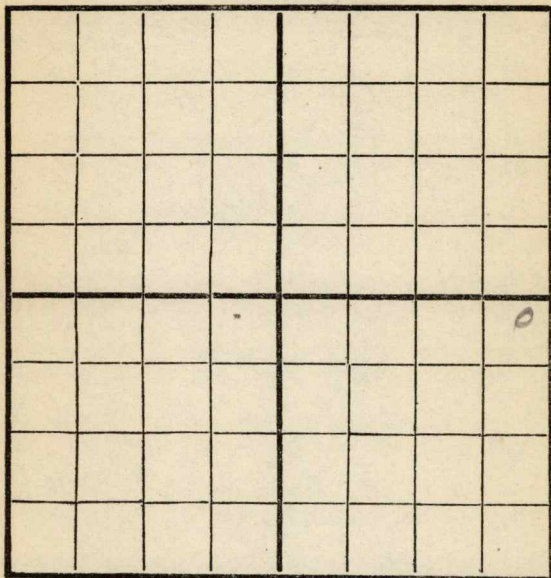

EAST

SOUTH

Location _____

Rig Up ☒ _____

Drilling and remarks _____

RECORD

Cased _____ in. _____ Ft.

Sand _____

Gas _____

Oil _____

Total Depth _____

PRODUCTION

1st 24 hrs. Nat. _____

1st 24 hrs. after shot _____

Gas _____ Cu. Ft.

Dry Hole _____

Abandoned _____

Date


3/26, 1917 C. C. C. S. Scout

Map No. _____ Sec. 34 Twp. 28 R. 4Well No. 1 Thompson Farm _____

Company _____

NORTH

WEST

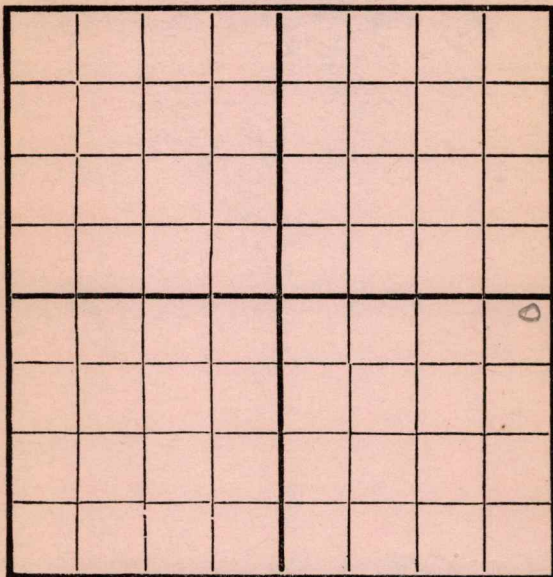

EAST

SOUTH

Location _____

Rig Up ✓ _____

Drilling and remarks _____

RECORD

Cased _____ in. _____ Ft.

Sand _____

Gas _____

Oil _____

Total Depth _____

PRODUCTION

1st 24 hrs. Nat. _____

First 24 hrs. after shot _____

Gas _____ Cu. Ft.

Dry Hole _____

Abandoned _____


Date

4/4, 1917 Conley Scout

Map No. _____ Sec. 34 Twp. 28 R. 4
 Well No. 1 Thompson Farm
Hendrick Company

NORTH

WEST

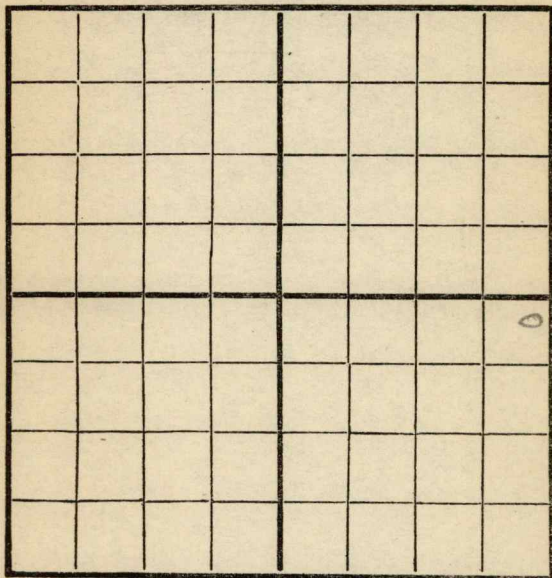

EAST

SOUTH

Location _____
 Rig Up ✓ _____
 Drilling and remarks _____

RECORD

Cased _____ in. _____ Ft.
 Sand _____
 Gas _____
 Oil _____
 Total Depth _____

PRODUCTION

1st 24 hrs. Nat. _____
 1st 24 hrs. after shot _____
 Gas _____ Cu. Ft.
 Dry Hole _____
 Abandoned _____

Date


4/10, 1917 Cordiff Scout

Map No. _____ Sec. 34 Twp. 28 R. 4
 Well No. 1 Thompson Farm
Heinrichs Oil Company

NORTH

WEST

EAST

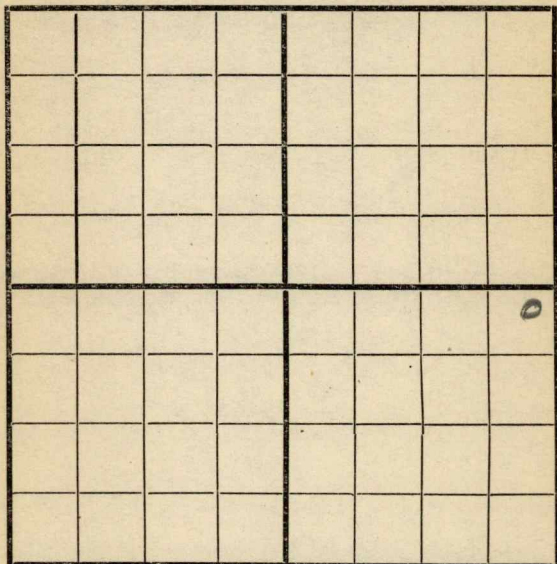

SOUTH

Location _____
 Rig Up _____
 Drilling and remarks _____

RECORD

Cased _____ in. _____ Ft.
 Sand _____
 Gas _____
 Oil _____
 Total Depth _____

PRODUCTION

1st 24 hrs. Nat. _____
 1st 24 hrs. after shot _____
 Gas _____ Cu. Ft.
 Dry Hole _____
 Abandoned _____


Date

4/17, 1917 Quincy Scout

Map No. _____ Sec. 34 Twp. 28 R. 4
 Well No. 19 Thompson Farm _____
Thompson Oil Company _____

NORTH

WEST

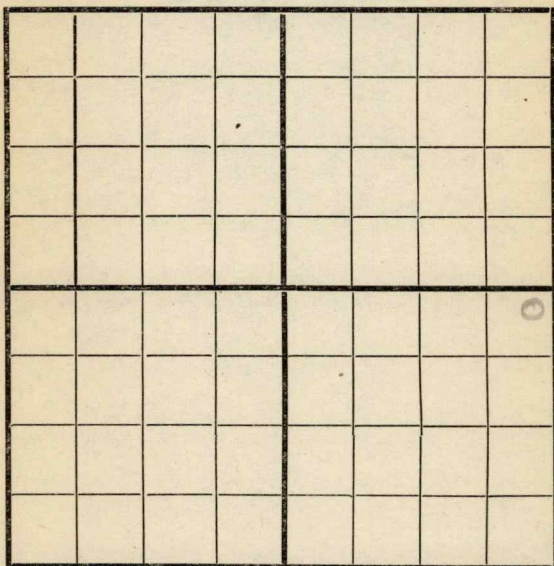

EAST

SOUTH

Location _____

Rig Up _____

Drilling and remarks _____

RECORD

Cased _____ in. _____ Ft.

Sand _____

Gas _____

Oil _____

Total Depth _____

PRODUCTION

1st 24 hrs. Nat. _____

1st 24 hrs. after shot _____

Gas _____ Cu. Ft.

Dry Hole _____

Abandoned _____


Date

4/34, 191 7 Randy Scout

Map No. _____ Sec. 34 Twp. 28 R. 4Well No. 19 Thompson Farm _____Hercules Company _____

NORTH

WEST

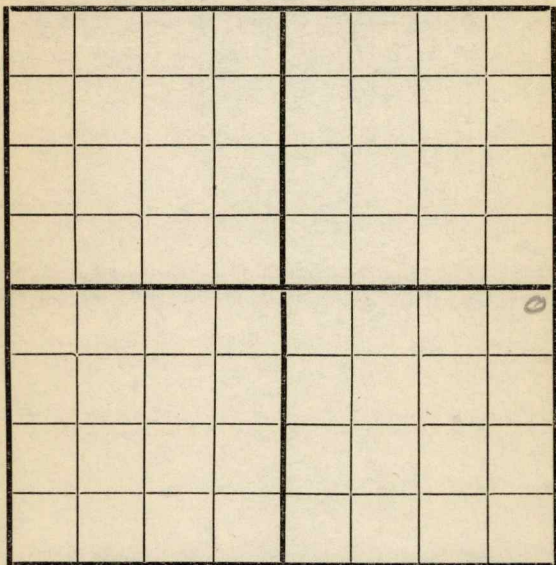

EAST

SOUTH

Location _____

Rig Up _____

Drilling and remarks _____

RECORD

Cased _____ in. _____ Ft.

Sand _____

Gas _____

Oil _____

Total Depth _____

PRODUCTION

1st 24 hrs. Nat. _____

1st 24 hrs. after shot _____

Gas _____ Cu. Ft.

Dry Hole _____

Abandoned _____

Date

5/2, 1912 Carbide Scout

Butler

K11
MAP NO. **KANSAS** SEC. 34 TWP. 28S R. 4EWELL NO. 1 Thompson
Hercules Oil COMPANY

CONTRACTOR

SECTION PLAT

ABANDONED

_____ FT. FROM N. LINE

_____ FT. FROM S. LINE

_____ FT. FROM E. LINE

_____ FT. FROM W. LINE

LOCATION ✓RIG UP out

DRILLING AND REMARKS:

abandoned

RECORD

CASED _____ IN. _____ FT.

SAND _____

GAS _____

OIL _____

TOTAL DEPTH _____

PRODUCTION

1ST 24 HRS. NAT. _____

1ST 24 HRS. AFTER SHOT _____

GAS _____ CU. FT.

DRY HOLE _____

ABANDONED ✓


DATE

7/22 1919 _____ SCOUT

Map No. _____ Sec. 34 Twp. 28 R. 4
 Well No. 1 Thompson Farm
Hercules Company

NORTH

WEST

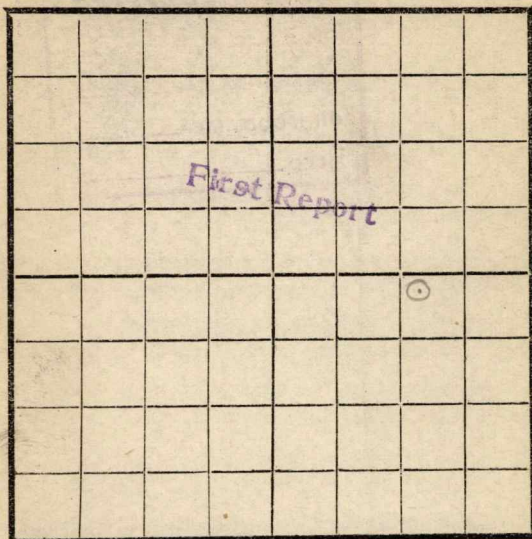

EAST

SOUTH

Location _____
 Rig Up ☒ _____
 Drilling and remarks _____

RECORD

Cased _____ in. _____ Ft.
 Sand _____
 Gas _____
 Oil _____
 Total Depth _____

PRODUCTION

1st 24 hrs. Nat. _____
 1st 24 hrs. after shot _____
 Gas _____ Cu. Ft.
 Dry Hole _____
 Abandoned _____

Date

8-27, 1917 Lantz Scout

Map No. 1740 Sec. 27 Twp. 18 R.

Well No. 1 Thompson

Company

Contractor

NORTH

WEST

EAST

SOUTH

Location _____

Rig up _____

Drilling and Remarks:

RECORD

Cased-----in., -----ft.

Sand_____

Gas

Oil _____

Total Depth_____

PRODUCTION

1st 24 hrs. Nat. -----

1st 24 hrs. after shot-----

Gas.....Cu. Ft.

Dry Hole

Abandoned_____

Date _____

191

Scout