


Map No. _____ Sec. 34 Twp. 28 R. 4Well No. 1 Harrod FarmUnited Producing Company

NORTH

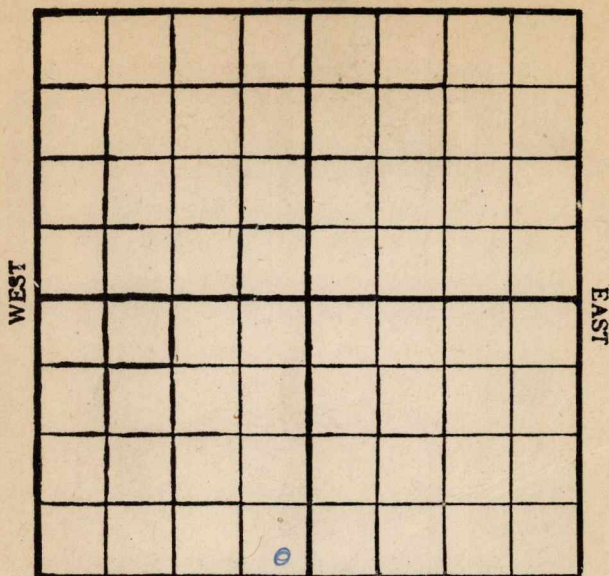

SOUTH

Location _____

Rig Up _____

Drilling Remarks:

Drilling Remarks:

COMPLETED

RECORD

Cased _____ in. _____ ft.

Sand _____

Gas _____

Oil _____

Total Depth _____

PRODUCTION


1st 24 hrs. Nat. _____

1st 24 hrs. after shot _____

Gas _____ cu. ft.

Dry Hole _____

Abandoned _____

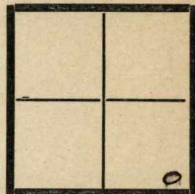Map No. _____ Sec. 34 Twp. 28 R. 4Well No. 1 Harrow Farm __________
United Prod. Company __________
Contractor __________
Sw. Quarter __________
Ft. from N. Line200 Ft. from S. Line200 Ft. from E. Line_____
Ft. from W. Line~~10/10~~

REPORT

11/10 Set 8 1/4" - 2240'12/10 Set 2660'17/10 U. R. 6 5/8 to 2660'23 U. R. 6 5/8" to 2660'29 Set 2855. N 7 W7/4 Set 3000'2/11 Set 3110'24 i i3/3 U. R. 5 3/16 to 3110'23 Set 3245'4/2 Set 32809 Set 33506/1 Set 3520

COMPLETED

Map No. K11 Sec. 34 Twp. 28 R. 4Well No. 1 HaroldUnited Producing CompanyContractor

NORTH

WEST

EAST

SOUTH

RECORD

Location _____

Cased _____ in., _____ ft.

Rig up ☒

Sand _____

Drilling and Remarks:

Gas _____

Oil _____

Total Depth _____

FIRST REPORT

PRODUCTION

1st 24 hrs. Nat. _____

1st 24 hrs. after shot _____

Gas _____ Cu. Ft.

Dry Hole _____

Abandoned _____

Date

11/21 1918 Condy Scout

Map No. 17 Sec. 34 Twp. 28 R. 7

Well No. 1344

United Prod Company

Ed Bolina Contractor

August NORTH 76

[illegible]

SOUTH

Location _____

Rig up

Drilling and Remarks:

Rigged up

RECORD

Cased_____in., _____ft.

Sand_____

Gas _____

Oil _____

Total Depth_____

PRODUCTION

1st 24 hrs. Nat. -----

1st 24 hrs. after shot.....

Gas_____Cu. Ft.

Dry Hole

Abandoned.....

Date _____

11/22 191 J. Conley Scout


Map No. K 11 Sec. 34 Twp. 28 R. 4Well No. HarrahUnited Pro Company

Contractor

NORTH

WEST

EAST

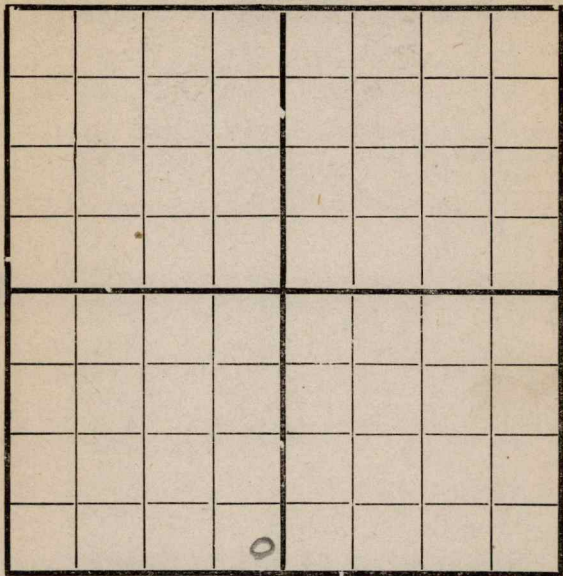

SOUTH

RECORD

Location _____

Cased _____ in., _____ ft.

Rig up _____

Sand _____

Drilling and Remarks:

Gas _____

Oil _____

Total Depth _____

PRODUCTION

1st 24 hrs. Nat. _____

1st 24 hrs. after shot _____

Gas _____ Cu. Ft.

Dry Hole _____

Abandoned _____

Date

12/4 191 8 Condy Scout

Map No. K 11 Sec. 34 Twp. 28 R. 4Well No. 1, 9, 10, 11,100United Producing Company

Contractor

NORTH

WEST

EAST

SOUTH

Location _____

Rig up _____

Drilling and Remarks:

Rigged up

RECORD

Cased _____ in., _____ ft.

Sand _____

Gas _____

Oil _____

Total Depth _____

PRODUCTION

1st 24 hrs. Nat. _____

1st 24 hrs. after shot _____

Gas _____ Cu. Ft.

Dry Hole _____

Abandoned _____

Date


12/18 191 8 C. C. C. Scout

Map No. K11 Sec. 34 Twp. 28 R. 4
 Well No. 1 Hannah
United Producing Company
 Contractor

NORTH

WEST

EAST

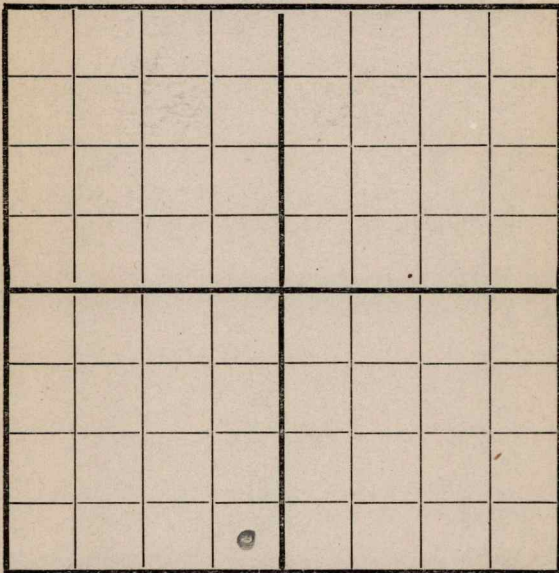

SOUTH

RECORD

Location _____

Cased _____ in., _____ ft.

Rig up _____

Sand _____

Drilling and Remarks:

Gas _____

Oil _____

Total Depth _____

PRODUCTION

1st 24 hrs. Nat. _____

1st 24 hrs. after shot _____

Gas _____ Cu. Ft.

Dry Hole _____

Abandoned _____

Date

12/11 191 J. C. Cady Scout


Map No. K 11 Sec. 34 Twp. 28 R. 4Well No. 1 HaystackUnited Pro Company

Contractor

NORTH

WEST

EAST

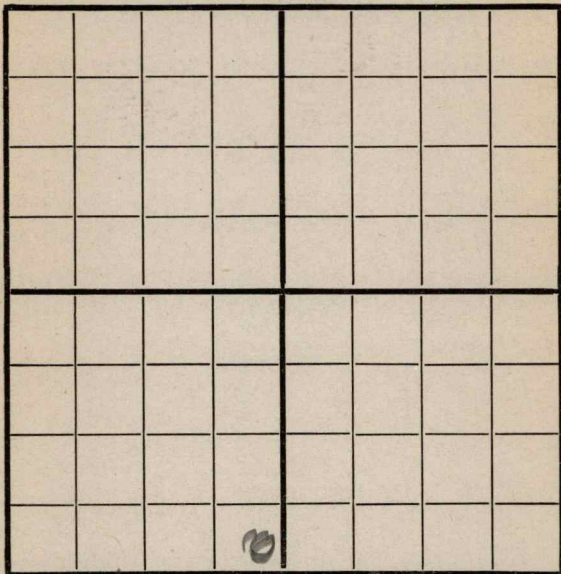

SOUTH

RECORD

Location _____

Cased _____ in., _____ ft.

Rig up _____

Sand _____

Drilling and Remarks:

Gas _____

Oil _____

Total Depth _____

PRODUCTION

1st 24 hrs. Nat. _____

1st 24 hrs. after shot _____

Gas _____ Cu. Ft.

Dry Hole _____


Abandoned _____

Date

191

Scout

Map No. 511 Sec. 34 Twp. 28 R. 4
 Well No. 1 Harrah
United Pro Company
 Contractor

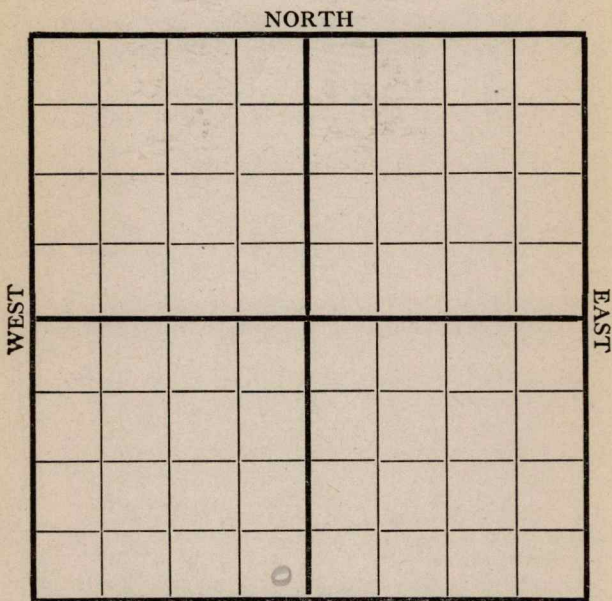

20082E

Location _____
 Rig up _____
 Drilling and Remarks:

22 10'

RECORD

Cased _____ in., _____ ft.
 Sand _____
 Gas _____
 Oil _____
 Total Depth _____

PRODUCTION

1st 24 hrs. Nat. _____
 1st 24 hrs. after shot _____
 Gas _____ Cu. Ft.
 Dry Hole _____
 Abandoned _____

Date

1/1 191 9 Quincy Scout

Map No. K11 Sec. 34 Twp. 28 R. 4
Well No. 1 Harold
United Pro Company
Contractor

NORTH							
WEST							
							EAST
SOUTH							

200 DYE

Location _____

Rig up _____

Drilling and Remarks:

AD 10'

RECORD

Cased _____ in., _____ ft.

Sand _____

Gas _____

Oil _____

Total Depth _____

PRODUCTION

1st 24 hrs. Nat. _____

1st 24 hrs. after shot _____

Gas _____ Cu. Ft.

Dry Hole _____

Abandoned _____

Date

1/15 9 Conroy Scout
191


Map No. 1511 Sec. 34 Twp. 28 R. 4Well No. 1 HaroldUnited Pro Company

Contractor

NORTH

WEST

EAST

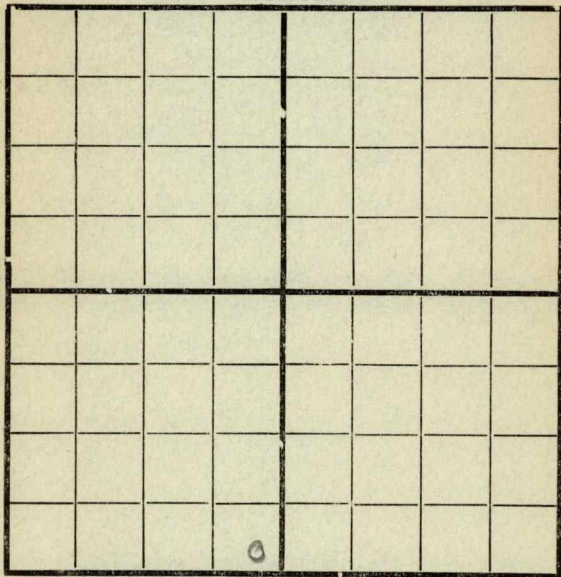

SOUTH

RECORD

Location _____

Cased _____ in., _____ ft.

Rig up _____

Sand _____

Drilling and Remarks:

Gas _____

Oil _____

Total Depth _____

PRODUCTION

1st 24 hrs. Nat. _____

1st 24 hrs. after shot _____

Gas _____ Cu. Ft.

Dry Hole _____

Abandoned _____

Date

191

Scout


Map No. K 11 Sec. 34 Twp. 28 R. 4Well No. 1 Harrah
United Pro Company

Contractor

NORTH

WEST

EAST

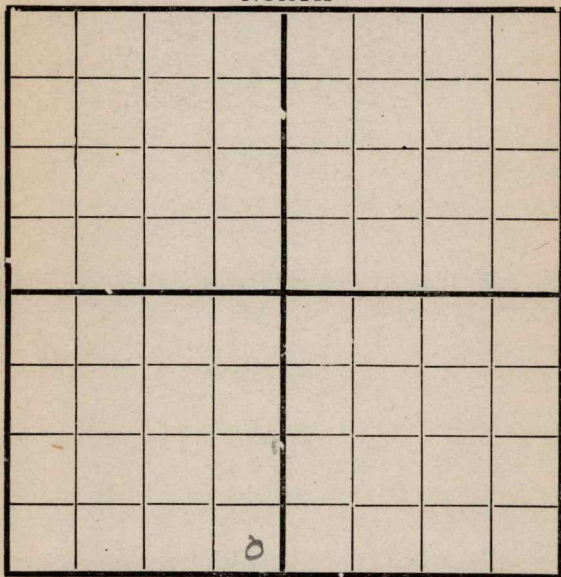

SOUTH

20089E

RECORD

Location _____

Cased _____ in., _____ ft.

Rig up _____

Sand _____

Drilling and Remarks:

Gas _____

Oil _____

Total Depth _____

PRODUCTION

1st 24 hrs. Nat. _____

1st 24 hrs. after shot _____

Gas _____ Cu. Ft.

Dry Hole _____

Abandoned _____

Date

7/22 191 9 Quincy Scout


Map No. K11 Sec. 34 Twp. 28 R. 4Well No. 1 Hayrah
United Prod Company

Contractor

NORTH

WEST

EAST

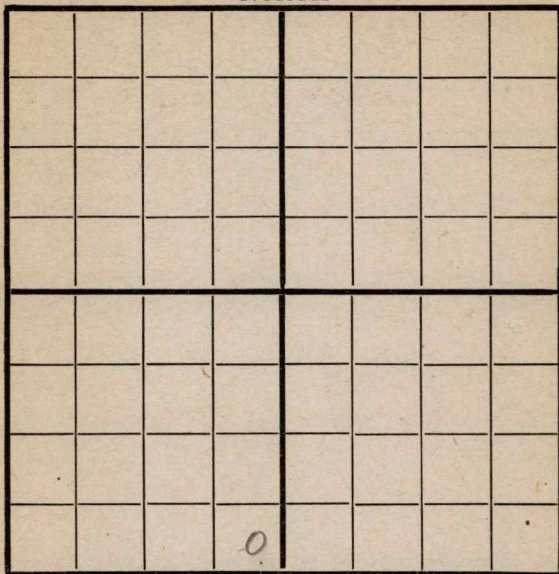

SOUTH

200 S. E

Location _____

Rig up _____

Drilling and Remarks:

1075'

RECORD

Cased _____ in., _____ ft.

Sand _____

Gas _____

Oil _____

Total Depth _____

PRODUCTION

1st 24 hrs. Nat. _____

1st 24 hrs. after shot _____

Gas _____ Cu. Ft.

Dry Hole _____

Abandoned _____

Date

3/8

1919

Pyle

Scout

K11 **KANSAS** SEC. 34 TWP. 28S R. 4E

WELL NO. 1 Hamm
United Pro & Ref COMPANY

CONTRACTOR

SECTION PLAT

ABANDONED

_____ FT. FROM N. LINE

_____ FT. FROM S. LINE

_____ FT. FROM E. LINE

_____ FT. FROM W. LINE

LOCATION _____

RIG UP _____

DRILLING AND REMARKS:

RECORD

CASED _____ IN. _____ FT.

SAND _____

GAS _____

OIL _____

TOTAL DEPTH 3570

PRODUCTION

1ST 24 HRS. NAT. _____

1ST 24 HRS. AFTER SHOT _____

GAS _____ CU. FT.

DRY HOLE ☒

ABANDONED ☒

DATE

4/28 1920

SCOUT

Map No. K 11 Sec. 34 Twp. 28 R. 4Well No. 1 HannahUnited Producers Company

Contractor

SECTION PLAT

Ft. from N. Line

200 Ft. from S. Line200 Ft. from E. Line

Ft. from W. Line



Location

Rig up

Drilling and Remarks:

RECORD

Cased _____ in., _____ ft.

Sand _____

Gas _____

Oil _____

Total Depth _____

PRODUCTION

1st 24 hrs. Nat. _____

1st 24 hrs. after shot _____

Gas _____ Cu. Ft.

Dry Hole 3520'

Abandoned _____

Date

5/1 191

Pyle

Scout

Scott