


Map No. 11 Sec. 26 Twp. 30 R. 5

Well No. 1 J. L. Reeves Farm
Calahan Etal Company

NORTH

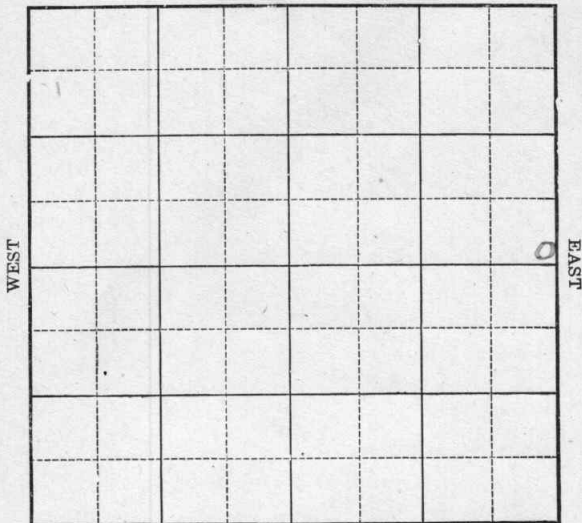

SOUTH

FIRST REPORT COMPLETED

Location _____

Rig Up _____

Drilling Remarks:

Drilling Remarks:

RECORD

PRODUCTION

Cased _____ in. _____ ft.

Sand _____

Gas _____

Oil _____

Total Depth _____

1st 24 hrs. Nat. _____

1st 24 hrs. after shot _____

Gas _____ cu. ft.

Dry Hole _____

Abandoned _____

Kansas

Map No. K 11 Sec. 36 Twp. 30 R. 5

Well No. 1 J. L. Reeves
Calshaw et al Company

Contractor

FIRST REPORT

SECTION PLAT

----- Ft. from N. Line

200 Ft. from S. Line

200 Ft. from E. Line

----- Ft. from W. Line

| | | | |
|--|--|--|---|
| | | | |
| | | | ○ |
| | | | |
| | | | |

Location -----

Rig up -----

Drilling and Remarks:

R. D. G.

RECORD

Cased ----- in., ----- ft.

Sand -----

Gas -----

Oil -----

Total Depth -----

PRODUCTION

1st 24 hrs. Nat. -----

1st 24 hrs. after shot -----

Gas ----- Cu. Ft.

Dry Hole -----

Abandoned -----

Date

MAR 30 1922

M. A. BENEAR

----- 191 -----

----- Scout

Map No. *State 11* Sec. *26* Twp. *30* R. *5*

Well No. *J. L. Reeves*

J. L. Salamon Company

Contractor

ABANDONED

SECTION PLAT

----- Ft. from N. Line
200' Ft. from S. Line
200' Ft. from E. Line
----- Ft. from W. Line

| | | | |
|--|--|--|---|
| | | | |
| | | | 0 |
| | | | |
| | | | |

Location -----
Rig up -----
Drilling and Remarks:

RECORD

Cased ----- in., ----- ft
Sand -----
Gas -----
Oil -----
Total Depth -----

PRODUCTION

1st 24 hrs. Nat. -----
1st 24 hrs. after shot -----
Gas ----- Cu. Ft
Dry Hole *55* -----
Abandoned *2925* -----

Date

AUG 13 1922 191 -----

M. A. BENEAR

Scour -----