


Section 1 Township 28 Range 5E

Well No. #1 Haines

Company Hammer & McLean Drlg.

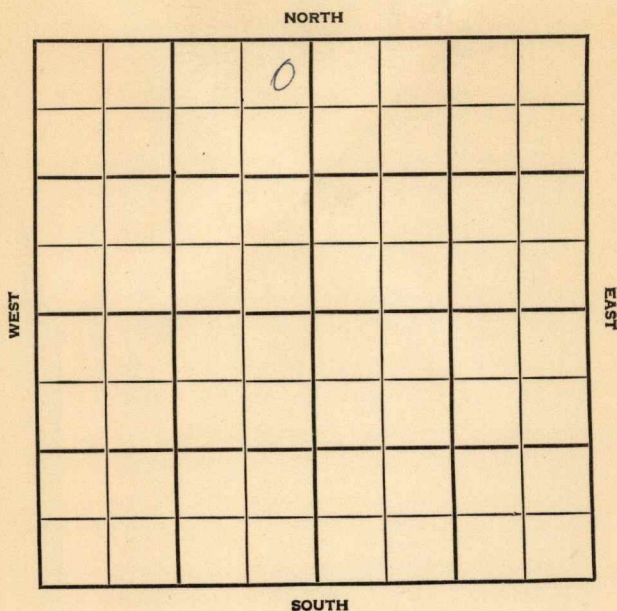

County Butler Elev. _____
 Sec. 1 Twp. 28 Rge. 5E
 Company Hammer & McLean Drlg.
 Farm Name Haines No. 1

TOPS	DEPTH	LOG	DATUM	Loc. in Sec.									
Anh.				NE NE NW									
Tr.				twin									
Dg.				200' EL									
Bl.				Geol. _____									
L.				Contr. _____									
K.C.				Co. tools									
B.K.C.				Pool									
Ce.				Weaver									
C.				<table border="1"> <tr> <td></td> <td>o</td> <td></td> </tr> <tr> <td colspan="3" style="text-align: center;">FIRST REPORT</td> </tr> <tr> <td></td> <td>JAN 9 '57</td> <td></td> </tr> </table>		o		FIRST REPORT				JAN 9 '57	
	o												
FIRST REPORT													
	JAN 9 '57												
M.													
K.													
Mz.													
Mq.													
V.													
S.													
A.													
R.													
Pe.													
G.													
TR.													

Date Comm. 1-8-57

~~27~~

Co.

Lse.

No.

Sec.

T.

R.

County Butler Elev. 1274
 Sec. 1 Twp. 26 Rge. 5E
 Company Hammer & McLean Drlg.
 Farm Name Haines No. 1

TOPS	DEPTH	LOG	DATUM	Loc. in Sec.
Anh.				NE NE NW
TP.				
H.				twin
Tr.				
Dg.				200' EL
Bl.				
L.				Geol.
K.C.	2070			
B.K.C.	<i>part 1st</i> 2644			Contr.
Ce.				Co. tools
C.				
M.	2692			Pool
M.				Weaver
K.				
Mz.				
Mo.				
V.				
S.				
S.				
A.				
R.				
Pe.				
G.				
T.D.	2725			

ABANDONED
 JAN 23 '57

Date Comm. 1-8-57

JAN 15 '57

10" @ 60 2676

JAN 23 '57

DEA