


SECTION 31 TOWNSHIP 13 RANGE 14W

WELL NO. #3 Smith "A"

COMPANY Icer Addis

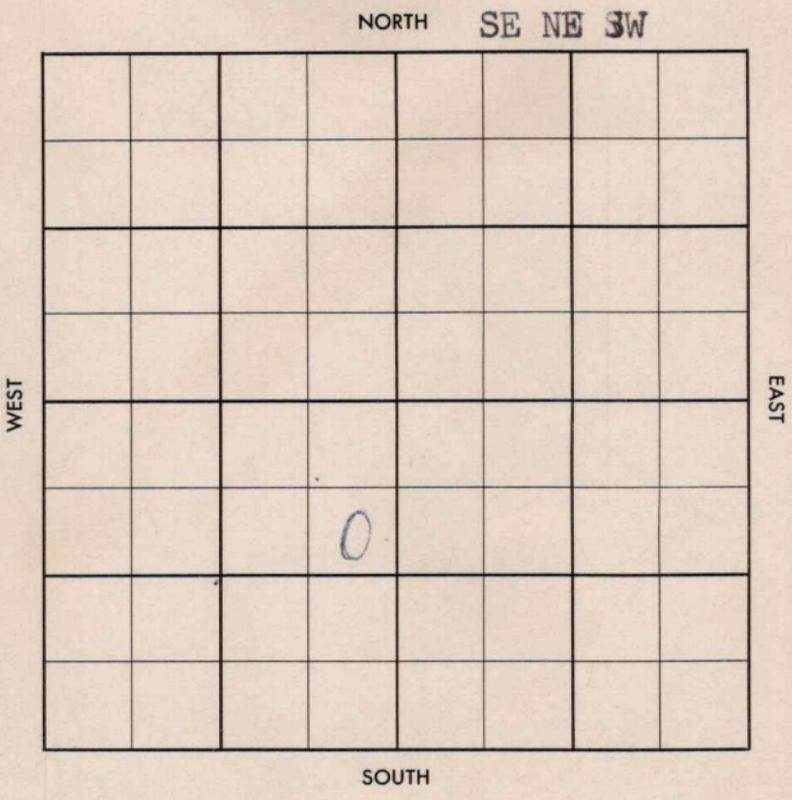

13

County Russell Elev. _____
 Sec. 31 Twp. 13 Rge. 14W
 Company Icer Addis
 Farm Name Smith "A" No. 3

Co.

TOPS	DEPTH	LOG	DATUM	Loc. in Sec.
Anh.				SE NE SW
Tp.				
H.				
Tr.				
Dg.				
B.L.				
L.				Geol. _____
K.C.				Contr. _____
B.K.C.				
Ce.				Duke Drlg.
C.				
M.				Pool
M.				
K.				
Mz.				Russell
Mq.				
V.				
S.				
S.				
A				
R.				
Pe.				
G.				
T.D.				

Lse.

FIRST REPORT
 SEP 11 1957

No.

Date Comm. M I R


Sec.

T.

R.

County Russell Elev. _____
 Sec. 31 Twp. 13 Rge. 14W
 Company Icer Addis
 FarmName Smith "A" No. 3

TOPS	DEPTH	LOG	DATUM	Loc. in Sec.
Anh.	910			SE NE SW
Tp.				
H.	2975			
Tr.				
Dg.				
Bl.				
L.	3027			Geol.
K.C.				Contr.
B.K.C.				Duke Drlg.
Ce.				
C.				
M.				Pool
M.				Russell
K.				
Mz.				
Mo.				
V.				
S.				
A	3305			
R.				
Pe.				
G.				
TD	3320			

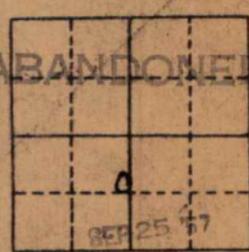

Date Comm. M I R SEP 18 57 9-9-57 85 914/450
3035 SEP 25 57 DST 3299-3315
60" 110' MO BHP 130/30" DST
3314-20 60" 310' WCM + 45' SW
BHP 320 NOLOG

DBA

Co.
No.
Sec.
T.
R.