


Cowley KANSAS

FORM 51 5M 2-38 TPCO.

Section 29 Township 30 Range 5-E

Well No. 1 "A" Dunbar (Twin to Dry hole)


Company Phelps & Spencer

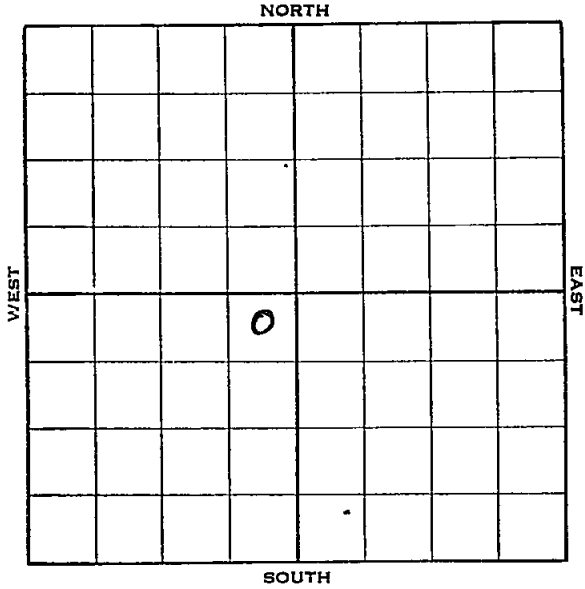

Sec. 29 Twp. 30 R. 5-E

Well No. #1 "A" Dunbar (Twin to dry hole)
Phelps & Spencer Company

375 Ft. from N. Line
 _____ Ft. from S. Line
330 Ft. from E. Line
 _____ Ft. from W. Line

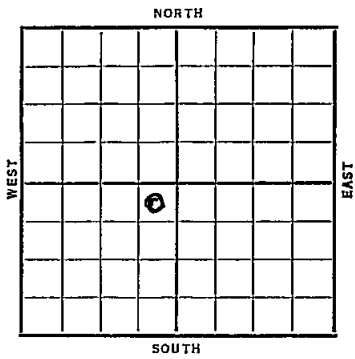

Date	REPORT
1938	
7/27	12" - 335'.
8/5	Drlg. 500'.
8/12	10" - 1046'. Dlg. 1145'.
8/19	8" - 1487'. Dlg. 1830'.
8/26	Dlg. 2180'.
9/2	S.D. 2225'.
9/9	K. C. 2229'. S. O. 2236'.
9/16	5" - 2236'. T. D. 2265'.
9/23	800' oil.
9/28	1500 acid. Pump 171 bbls. 21 hrs.
9/28	Testing.
9/28	"
9/28	5" - 2236'.
9/28	K. C. 2229'.
9/28	T. D. 2265'.
9/28	Pump & flow 109 bbls. 4 hrs. &
9/28	114 bbls. 4 hrs.
9/28	Potential 658 oil & 30 water.
9/28	Gravity 39.2 / 68

COMPLETED

Cowley KANSAS

Map No. 11 Sec. 29 Twp. 30 R. 5EWell No. 1 "A" Dunbar (Twin to Dry Ho
Phelps & Spencer Company

Contractor

FIRST REPORT

NE SW

375 Ft. from N. Line

_____ Ft. from S. Line

330 Ft. from E. Line

_____ Ft. from W. Line

SECTION PLAT

	0		

Location _____

Rig up _____

Drilling and Remarks:

12" - 335Drlg. 500

RECORD

Cased _____ in., _____ ft.

Sand _____

Gas _____

Oil _____

Total Depth _____

PRODUCTION

1st 24 hrs. Nat. _____

1st 24 hrs. after shot _____

Gas _____ Cu. Ft.

Dry Hole _____

Abandoned _____

Date

JUL 27 1938 19H. D. Hatfield Scout

