

31


13S

14W

SECTION _____ TOWNSHIP _____ RANGE _____

WELL NO. #3 Smith "B"

COMPANY Icer Addis

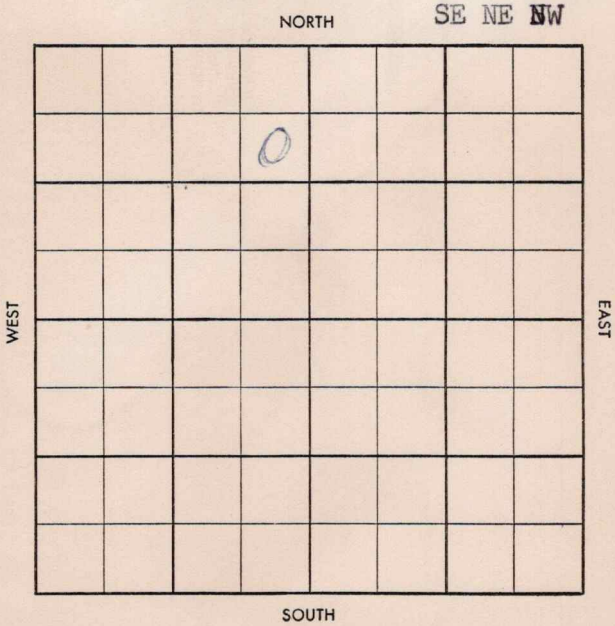

CO. Russell ELEV. _____SEC. 31 TWP. 13 RGE. 14WCOMPANY Icer Addis NO. 3FARM Smith "B"LOC. SE NE NW

GEOL. Don VaughanCONTR. Triangle toolsPOOL Gorham

SPUD _____

8" @ 900 Drlg. 2710

CO.

FIRST REPORT

LSE.

NO.

SEC.

TWP.

RGE.

S-513-A

CO. Russell ELEV. 18770FSEC. 31 TWP. 13 RGE. 14WCOMPANY Icer Addis NO. 3

NOV 13 '57

COMPLETE

FARM Smith "B"LOC. SE NE NW

A 910

H 2987

TR 3005

L 3040

A 3306

TD 3309

GEOL. Don VaughanCONTR. Triangle toolsPOOL GorhamSPUD 10-17-57

8" @ 900 Drlg. 2710

DST 3874-90

60" 1940' GIP

40' MGsy oil

160' O 20' W

BHP 675/20"

no log 5 1/2 3307 1/2

CO - PB 3316 @ 2 1/2 BOPH NW

N 1/4 @ 12 1/2 BOPH NW 6 hrs

500' OB POP

P 85 BOPH NW

25 BOPH NW

orb 3307 1/2 - 3316