
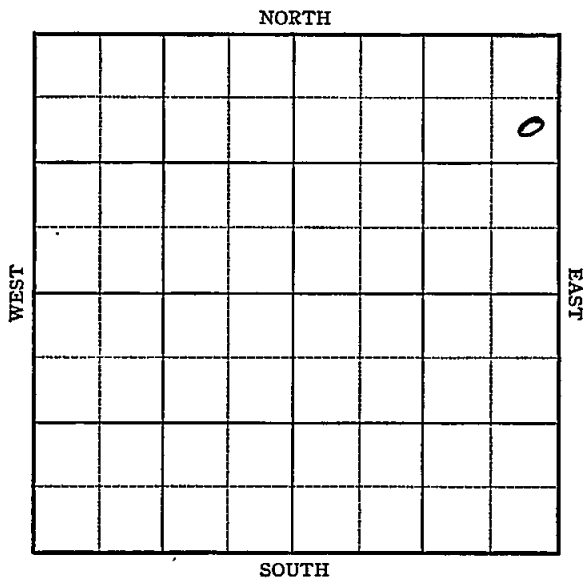


Section 27 Township 30 Range 5-EWell No. #1 StuberCompany Murta & Wilson et al

Sec. 27 Twp. 30 R. 5-EWell No. #1 Stuber Farm
Murta & Wilson et al Company990 Ft. from N. Line Ft. from S. Line330 Ft. from E. Line Ft. from W. Line

Elev. 1280

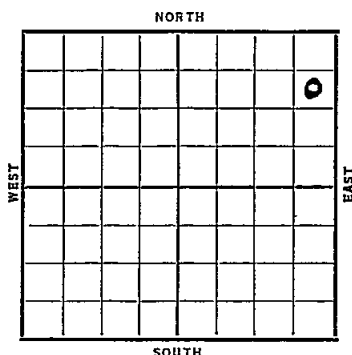

Date

REPORT

1937

10/27

Location

11/5

Spud.

11/12

15" @ 323'. Drlg. 925'.

11/19

12" @ 1046'. 10" @ 1485'. C.O.

11/26

10" @ 1572'. Drlg. 1885'.

12/3

8" @ 2055'. T.D. 2110' U.R.

12/10

8" @ 2078'. Drlg. 2380'.

12/17

6" @ 2482'. Drlg. 2780'.

12/22

Miss. 2905'.

T.D. 2915'.

ABANDONED

Cowley KANSAS

Map No. 11 Sec. 27 Twp. 30 R. 5EWell No. 1 StuberMurta & Wilson etal Company

Contractor

FIRST REPORT

SE NE NE

990 Ft. from N. Line Ft. from S. Line330 Ft. from E. Line Ft. from W. Line

SECTION PLAT

			0

Location XRig up

Drilling and Remarks:

RECORD

Cased in., ft.Sand Gas Oil Total Depth

PRODUCTION

1st 24 hrs. Nat. 1st 24 hrs. after shot Gas Cu. Ft.Dry Hole Abandoned

Date

OCT 27 1937H. D. Hatfield19

Scout

Cowley **KANSAS**Map No. 11 Sec. 27 Twp. 30 R. 5EWell No. 1 StuberMurta & Wilson etal Company

Contractor

ABANDONED

SE NE NE

990 Ft. from N. Line Ft. from S. Line330 Ft. from E. Line Ft. from W. Line

SECTION PLAT

			0

Location Rig up

Drilling and Remarks:

D & A

RECORD

Cased in., ft.~~Sand~~ MIS 2905Gas Oil Total Depth 2915

PRODUCTION

1st 24 hrs. Nat. 1st 24 hrs. after shot Gas Cu. Ft.Dry Hole Abandoned

Date

DEC 22 1937₁₉H. D. Hatfield Scout