


Section 31 Township 13 Range 14-W

Well Number 1 Smith (A)

Company Shell

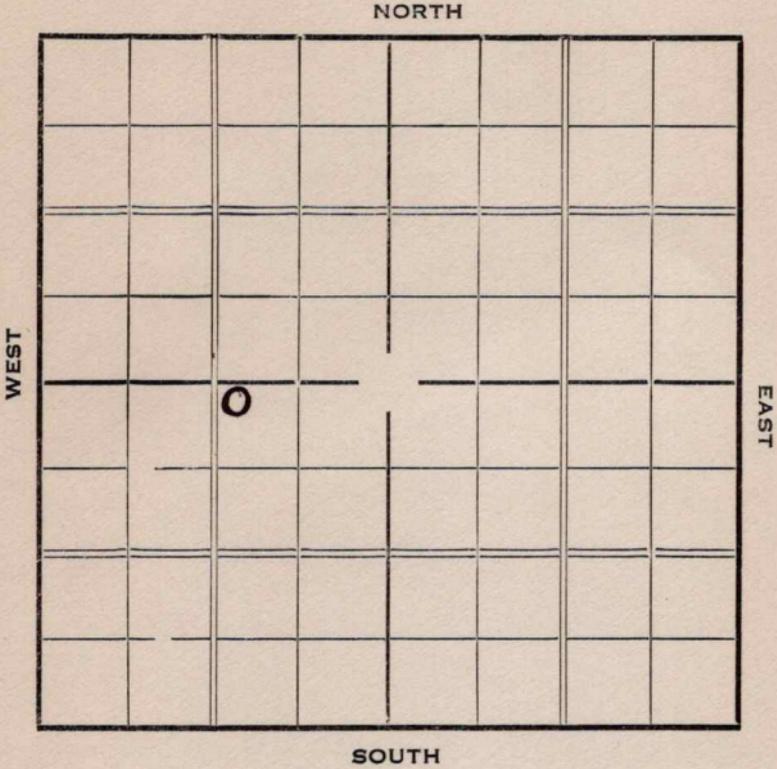

Sec. 31 Twp. 13 R. 14-W

Well No. #1 Smith (A) Farm

Shell Company


20 Ft. from N. Line

         Ft. from S. Line

1226 Ft. from E. Line

         Ft. from W. Line

**Elev. 1875**

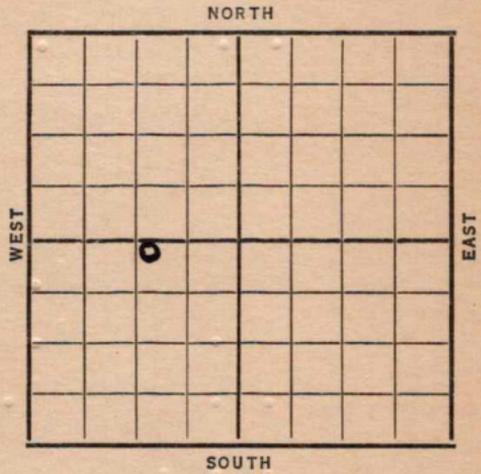

Date	REPORT
1937	
3/17	Ponds
3/25	Drlg. 850'.
4/2	Drlg. 1875'
4/8	Drlg. 2776'
4/16	Drlg. 3215'
4/23	<b>Sil. 3328'.</b> T.D. 3335'. SD.
4/30	5" @ 3324'. T.D. 3346'.
	RUST
5/7	T.D. 3348½'. 2350' water.
	P.B. 3282'.
5/14	" "
5/21	Will make salt water
	disposal well.
5/28	P.B. 3273'.
6/4	P.B. 3254' SD.
6/11	" " "
6/19	P.B. 2750'. Shot 6 shots.
	Small S. O. C.O.
6/25	T.D. 2816'. 170' water 7
	hrs. SDO
7/2	" "
	<b>OVER</b>

1937

7/9 P.B. 2793'. Will shoot.

7/14 5" @ 3324'.  
Sil. 3328'.  
T.D. 3348½'.  
H.F.W.  
P.B. 2793'.  
No oil.

**ABANDONED**

Map No. 72 Sec. 31 Twp. 13 R. 14W

Well No. 1 Smith

Shell Company

Contractor

**SECTION PLAT**

	0		

20 Ft. from N. Line

\_\_\_\_\_ Ft. from S. Line

1226 Ft. from E. Line

\_\_\_\_\_ Ft. from W. Line

**FIRST REPORT**

Location \_\_\_\_\_

Rig up \_\_\_\_\_

Drilling and Remarks:

Ponds

**RECORD**

Cased \_\_\_\_\_ in., \_\_\_\_\_ ft.

Sand \_\_\_\_\_

Gas \_\_\_\_\_

Oil \_\_\_\_\_

Total Depth \_\_\_\_\_

**PRODUCTION**

1st 24 hrs. Nat. \_\_\_\_\_

1st 24 hrs. after shot \_\_\_\_\_

Gas \_\_\_\_\_ Cu. Ft.

Dry Hole \_\_\_\_\_

Abandoned \_\_\_\_\_

Date

MAR 17 1937 19

S. J. LEWIS Scout

Russell **KANSAS**

Map No. \_\_\_\_\_ Sec. 31 Twp. 13 R. 14<sup>w</sup>

Well No. 1-Smith

Shell Company

Contractor \_\_\_\_\_

**ABANDONED**

20 Ft. from N. Line

\_\_\_\_\_ Ft. from S. Line

1226 Ft. from E. Line

\_\_\_\_\_ Ft. from W. Line

**SECTION PLAT**

	0		

Location \_\_\_\_\_

Rig up \_\_\_\_\_

Drilling and Remarks:

H.F.W.

P.B. 2793

NO oil

DYA

**RECORD**

Cased 5 in., 3324 ft.

Sand 511 3328

Gas \_\_\_\_\_

Oil \_\_\_\_\_

Total Depth 3348 1/2

**PRODUCTION**

1st 24 hrs. Nat. \_\_\_\_\_

1st 24 hrs. after shot \_\_\_\_\_

Gas \_\_\_\_\_ Cu. Ft.

Dry Hole \_\_\_\_\_

Abandoned \_\_\_\_\_

Date

JUL 14 1937 19

H. D. Hatfield

Scout