


Section 31 Township 13 Range 14-W

Well No. #1 Smith

Company Jones, Shelborne & Farmer

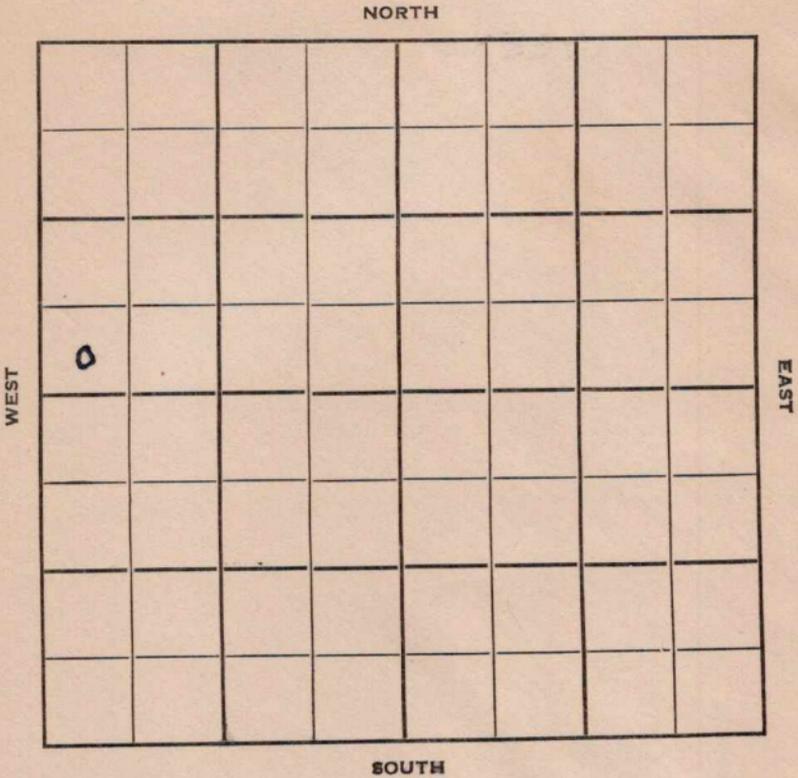

KANSAS

Russell

Sec. 31 Twp. 13 R. 14-W

Well No. #1 Smith Farm

Jones, Shelborne & Farmer Company

Contractor

Gorham


_____ Ft. from N. Line

330 Ft. from S. Line

_____ Ft. from E. Line

330 Ft. from W. Line

SW SW NW

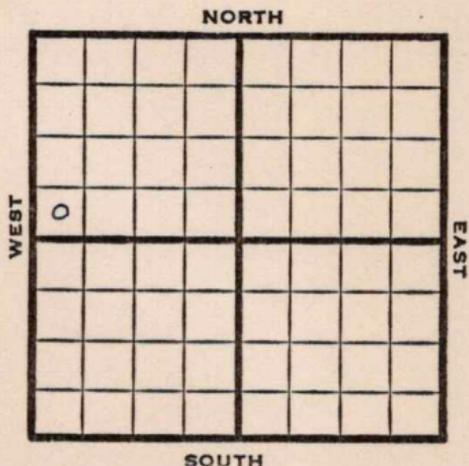

1950

Elev. 1875' REPORT

11/1

Location

1951

1/10

Spud 11-3-50

D&A TD 3350

15" @ 408' Anhy 911-52

13" @ 650 Tarkio 2500

8" @ 2515 Top 2750

Lans. 3035 Cong. 3311

Arb. 3328-50 TD HFW

D&A

ABANDONED


County Russell State Kansas

Sec. 31 (^{Blk.}_{Twp.}) 13 (^{Sur.}_{Rge.}) 14W Map No.

Operator Jones, Shelborne & Farmer

Well No. 1 Farm Smith

Elev. 1875 Location SW SW NW

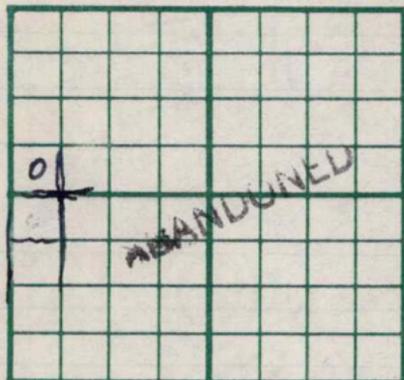

330 Ft. From S Line NW

330 Ft. From W Line Quarter

1st. Report

Completion JAN 10 1951

Remarks Gorham Pool

Spudding Date 11-3-50

Drlg. Data D & A TD 3350

15" @ 408 Anhy 911-52 13" @ 650

Tarkio 2500 8" @ 2515 Top. 2750

TD-2975 Lans. 3035 Cong. 3311

Arb. 3328-50 TD HFW

D & A