


Section 36 Township 28 Range 4 E

Well No. # 1 Stewart

Company White & Ellis

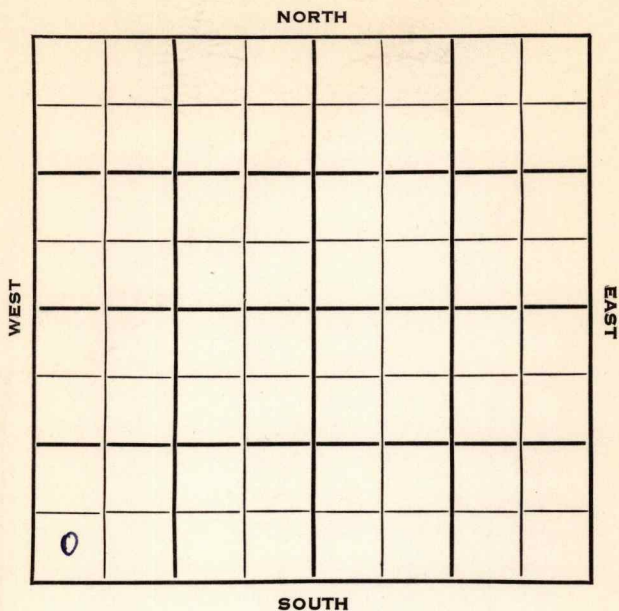

KANSAS

Butler

SEC. 36	TWP. 28	R. 4E	✓
------------	------------	----------	---

WELL NO. #1 Stewart FARM

COMPANY White & Ellis


CONTRACTOR White & Ellis Wildcat.

\_\_\_\_\_ Ft. from N. Line

330 \_\_\_\_\_ Ft. from S. Line

\_\_\_\_\_ Ft. from E. Line

330 \_\_\_\_\_ Ft. from W. Line

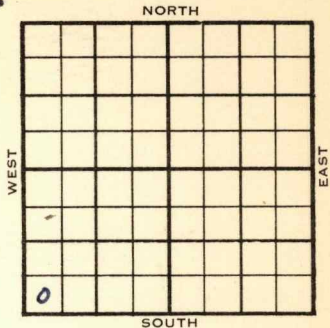

SW SW SW

1953	ELEVATION	REPORT
------	-----------	--------

12/30

Spud 12-19-53  
 8" @ 95'  
 Miss 2839'  
 TD 2869'  
 D & A

FIRST REPORT

ABANDONED

