


Map No. K Sec. 29 Twp. 30 R. 5

Well No. 1- Dunbar Farm _____
Alcon Company

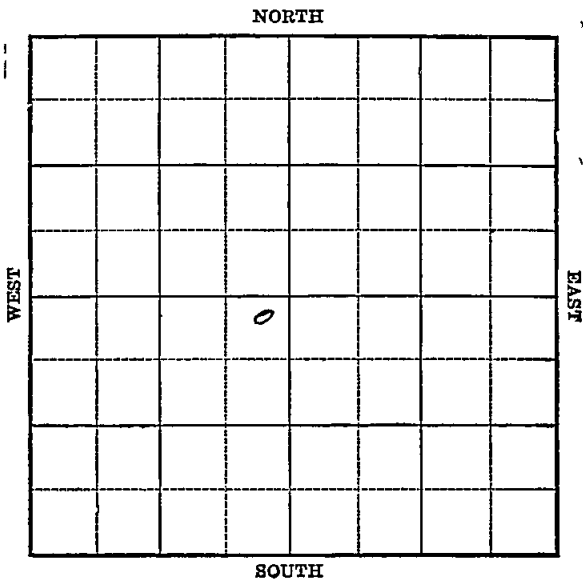

Location _____

Rig up _____

Drilling Remarks:

Drilling Remarks:

RECORD

PRODUCTION

Cased _____ in. _____ ft.
Sand _____
Gas _____
Oil _____
Total Depth _____

1st 24 hrs Nat. _____
1st 24 hrs. after shot _____
Gas _____ cu. ft.
Dry Hole _____
Abandoned _____

Map No. 15 Sec. 29 Twp. 30 R. 5


Well No. 1 Dunbar Farm
Alcorn Company

300 Ft. from N. Line

_____ Ft. from S. Line

330 Ft. from E. Line

_____ Ft. from W. Line

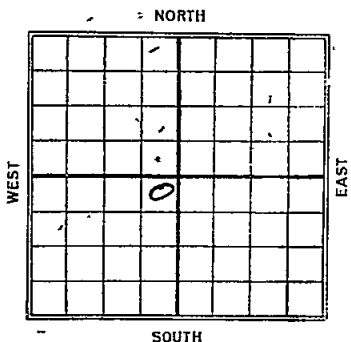

Date	REPORT
1924	
6/10	Rwy
7/16	D. 1000'
10/28	set 6" - 3115'
11/26	P.B. 2281' Shot 40 gts
	2265-81
12/17	S.D.
1925	
1/21	2265-81 40 gts
3/30	Abandoned 3380

11
 Map No. ~~448549~~ Sec. 29 Twp. 30 R. 5

Well No. 1 Lumber
 O'Connell Company

Contractor

FIRST REPORT

SECTION PLAT

300 Ft. from N. Line

_____ Ft. from S. Line

330 Ft. from E. Line

_____ Ft. from W. Line

	0		

Location _____

Rig up _____

Drilling and Remarks:

R.O. G

RECORD

Cased _____ in., _____ ft.

Sand _____

Gas _____

Oil _____

Total Depth _____

PRODUCTION

1st 24 hrs. Nat. _____

1st 24 hrs. after shot _____

Gas _____ Cu. Ft.

Dry Hole _____

Abandoned _____

Date

JUN 10 1924

192

M. A. BENEAR

Scout

Map No. 11 **KANSAS** Sec. 29 Twp. 30 R. 5

Well No. 1 Number

Alcorn Oil Company

Contractor

ABANDONED SECTION PLAT

300 Ft. from N. Line

_____ Ft. from S. Line

300 Ft. from E. Line

_____ Ft. from W. Line

Location _____

Rig up _____

Drilling and Remarks:



RECORD

Cased _____ in., _____ ft.

Sand _____

Gas _____

Oil _____

Total Depth _____

PRODUCTION

1st 24 hrs. Nat. _____

1st 24 hrs. after shot _____

Gas _____ Cu. Ft.

Dry Hole _____

Abandoned 3280

Date

3/30 1955

M. A. BENEAR

Scout