

Kansas

Map No. _____ Sec. 1 Twp. 28 R. 5

Well No. 3 Lague Farm

Derby, Streeter & Stearns Company

NORTH

WEST

EAST

SOUTH

Location _____

Drilling Remarks:

Rig Up_____

Drilling Remarks:

RECORD

Cased _____ in. _____ ft.

Sand _____

Gas _____

Oil_____

Total Depth _____

PRODUCTION

1st 24 hrs. Nat._____

1st 24 hrs. after shot_____

Gas_____cu. ft.

Dry Hole _____

Abandoned _____

Map No. _____ Sec. 1 Twp. 28 R. 5


Well No. # 3 Derby Wagon Farm
Derby Streeter Steam Company

200 Ft. from N, Line

_____Ft. from S. Line

Ft. from E. Line

660 Ft. from W. Line

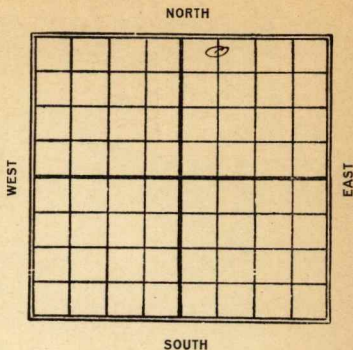

Date _____

REPORT

922

21

 $\frac{7}{22}$

Rig

Box 2694

Map No. Kans Sec. 1 Twp. 28 R. 5Well No. 3 TaguelHerby Street & Stearns Company

Contractor

FIRST REPORT

SECTION PLAT

		0	

-----Ft. from N. Line

-----Ft. from S. Line

-----Ft. from E. Line

-----Ft. from W. Line

Location -----

Rig up -----

Drilling and Remarks:

RECORD

Cased ----- in., ----- ft.

Sand -----

Gas -----

Oil -----

Total Depth -----

PRODUCTION

1st 24 hrs. Nat. -----

1st 24 hrs. after shot -----

Gas ----- Cu. Ft.

Dry Hole -----

Abandoned -----

Date

MAY 21 1922

M. A. BENEAR

191

Scout

Map No. Kans 11 Sec. 1 Twp. 28 R. 5Well No. 3 TagueCurly & Struter Company

Contractor

ABANDONED**SECTION PLAT**200' Ft. from N. Line

----- Ft. from S. Line

----- Ft. from E. Line

660 Ft. from W. Line

		0	

Location -----

Rig up -----

Drilling and Remarks:

RECORD

Cased ----- in., ----- f

Sand -----

Gas -----

Oil -----

Total Depth -----

PRODUCTION

1st 24 hrs. Nat. -----

1st 24 hrs. after shot -----

Gas ----- Cu. F

Dry Hole -----

Abandoned 2697 -----

Date

JUL 22 1922M. A. BENEAR

----- 191 -----

----- Scout