

Section 32 Township 30 Range 5E

Well No. 1 Martin

Company Bowman & Grissmore

NORTH

					0		

WEST

EAST

SOUTH

Cowley

KANSAS

SEC.	32	TWP.	30	R.	5E
------	----	------	----	----	----

WELL NO. #1 Martin FARM

COMPANY Bowman & Grissmore

CONTRACTOR Springer & Harper


Wildcat

_____ Ft. from N. Line

_____ Ft. from S. Line

_____ Ft. from E. Line

_____ Ft. from W. Line

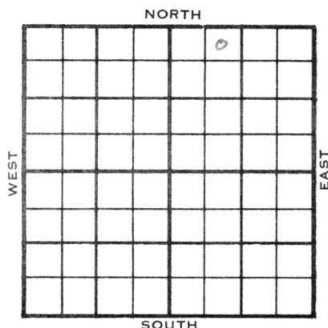

NE NW NE

	ELEVATION	REPORT
--	-----------	--------

1955

7/27

Spdg

8/3

8" @98 TD 2918 D&A

Bl. Stal	1865	581
L.	1860	576
KC	2234	950
BKC Oswego	2565	1281
Ce. Bart	2870	1586
M.	2893	1609
TD.	2918	

ABANDONED

County Cowley Elev. _____
 Sec. 32 Twp. 30V Rge. 5E
 Company Bowman & Grissmore
 Farm Name Martin No. 1

TOPS	DEPTH	LOG	DATUM
Anh.			
TP.			
H.			
Tr.			
Dg.			
BL.			
L.			
K.C.			
B.K.C.			
Ce.			
C.			
M.			
M.			
K.			
Mz.			
Mq.			
V.			
S.			
S.			
A.			
R.			
PE.			
G.			
T.D.			

Loc. in Sec. NE NW NE
 Geol. _____
 Contr. _____
 Pool Springer & Harper
Wildcat

FIRST RETURN
 JUL 27 '55

Date Comm. Spdg.

Co.
 Lse.
 No.
 Sec.
 T.
 R.

County **Cowley** Elev. _____
 Sec. **32** Twp. **30** Rge. **5E**
 Company **Bowman & Grissmore**
 Farm Name **Martin** No. **1**

TOPS	DEPTH	LOG	DATUM
Anh.			
Tp.			
H.			
Tr.			
Dg.			
Bl. <i>stal</i>	<i>186.5</i>		<i>581</i>
L.	<i>1860</i>		<i>576</i>
K.C.	<i>2234</i>		<i>950</i>
B.K.C. <i>Oswego</i>	<i>2565</i>		<i>1281</i>
Ce. <i>Bart</i>	<i>2870</i>		<i>1586</i>
C.			
M.	<i>2893</i>		<i>1609</i>
M.			
K.			
Mz.			
Mq.			
V.			
S.			
S.			
A.			
R.			
PE.			
G.			
TD.	<i>2918</i>		

Loc. in Sec. **NE NW NE**
 Geol. _____
 Contr. **Springer & Harper**
 Pool **Wildcat**

		0	

ABANDONED

Date Comm. **7-25-55** AUG 3 1955
8" @ 98 TD 2918

D & A

Co. No. Sec. T. R.