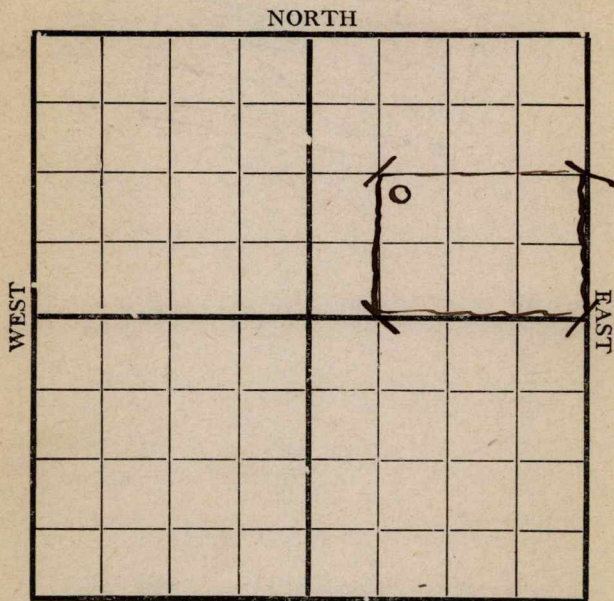


Map No. 111 Sec. 1 Twp. 28 R. 5Well No. 1 Tague
Gardner & Smith Company

Contractor

1120 S. 860 W

Location _____

Rig up ☒

Drilling and Remarks:

FIRST REPORT**RECORD**

Cased _____ in., _____ ft.

Sand _____

Gas _____

Oil _____

Total Depth _____

PRODUCTION

1st 24 hrs. Nat. _____

1st 24 hrs. after shot _____

Gas _____ Cu. Ft.

Dry Hole _____

Abandoned _____

Date

1/20 1919 Conley Scout

Map No. K 11 Sec. 1 Twp. 28 R. 5Well No. 1 Jaguel
Garden & Smith Company

Contractor

NORTH

WEST



EAST

SOUTH

1120 S860 W

Location _____

Rig up _____

Drilling and Remarks:

Shot 140 gts

RECORD

Cased _____ in., _____ ft.

Sand 2690 - 2738

Gas _____

Oil _____

Total Depth _____

PRODUCTION

1st 24 hrs. Nat. _____

1st 24 hrs. after shot _____

Gas _____ Cu. Ft.

Dry Hole _____

Abandoned 2745

Date

4/23 191 9Pyle Scout