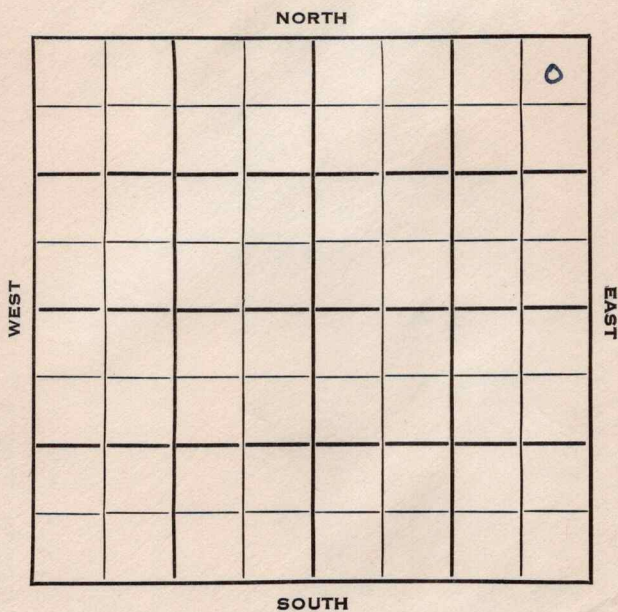


Section 31 Township 13 Range 11WWell No. 1 W. S. BrownCompany Kim Oil

SEC.	TWP.	R.
31	13	14 W ✓

WELL NO.

1 W. S. Brown

FARM

COMPANY

Kim Oil

CONTRACTOR

Sidey Drlg.
Atherton Pool


330 Ft. from N. Line

Ft. from S. Line

330 Ft. from E. Line

Ft. from W. Line

NE NE NE

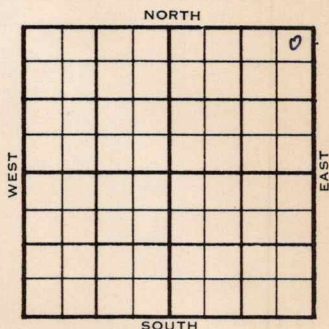

	ELEVATION	REPORT
1954	1874'	

2/24	Spud 2-15-54 8" @ 196' Anhy 915' Drlg. 2935'
3/3	Arb. 3315' RTD 3315' 5" @ 3315' DD 3317
3/10	Heeb 2989' Lans 3038' Arb. 3312 DD 3321' FU 1800' oil S/12 BO 15 hrs 500 A S/7 BOPH
3/17	NR
3/24	Spud 2-15-54 Oil Well TD 3321' 8" @ 196' Anhy 915', Heeb 2989', Lans 3038', Arb. 3312' TD 3315' 5" @ 3315' DD 3317 DD 3321' FU 1800' oil S/12 bo 15 hrs., 500A S/7 boph Comp. 25 bopd

COMPLETED

J. G. McGEHEE

