


Russell

Map No. **KANSAS** Sec. 37 Twp. 13 R. 14W

Well No. 1- Boyberger Farm
Hartman & Blair et al Company

NORTH

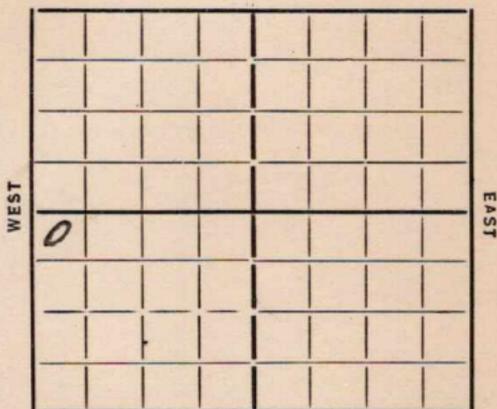

SOUTH

330 Ft. from N. Line

Ft. from S. Line

Ft. from E. Line

330 Ft. from W. Line

Elevation 1868

REPORT

O. W. D. D

Date	Notes
1/20	Rog
1/29	Rid
1/26	Rig
1/23	
1/19	SD
1/26	Rgn
1/23	
1/10	slg 375 15" 343
1/17	duhy 904 10" 915 woc
1/24	slg 1780
1/31	" 2300
2/7	8" 2565 Top Topeka 2760 slg 3005
2/14	" 3045 6" 3044
2/21	Lans 3039 so 3065 HFW 3120 so 3210-20 TD
2/28	TD 3220 6" 3150 Est 125 Bbls Net 5000 acid pumped 192 Bbls 7 1/2 hrs acid at shoulder of pipe
3/6	Re setting pipe Bailing

**OVER
OVER**

733064

3/13 6" 3150 Bly plug
3/25 Top line 3039
T.D. 3220
Two - 5000 Gal acid
pump 545 Bbls.

COMPLETED

1936

O. W. D. D

8/12 - Old T.D. 3220'
Sulphurous 3307-09' T.D.
Potential 385'
5" @ 3306', Waiting on Cement.

8/19/36 - Sil. 3306'.
T.D. 3311½'.
1000 gallons of acid.
Potential 644 bbls of oil in 18
hours.

COMPLETED

KANSAS

Map No. 72 Sec. 32 Twp. 13 R. 14 W

Well No. 1 - Bosberger

Hartman + Blair et al Company

Contractor

FIRST REPORTS

SECTION PLAT

0			

330 Ft. from N. Line

Ft. from S. Line

Ft. from E. Line

330 Ft. from W. Line

Location

Rig up

Drilling and Remarks:

Rog

RECORD

Cased in., ft.

Sand

Gas

Oil

Total Depth

PRODUCTION

1st 24 hrs. Nat.

1st 24 hrs. after shot

Gas Cu. Ft.

Dry Hole

Abandoned

Date

ORVAL MANNSCHRECK

11-20-35 192

Scout

Map No. 72 Sec. 22 Twp. 13 R. 14W

Well No. 1 Box Tegu

Hartman & Blair et al Company

Contractor

SECTION PLAT

330 Ft. from N. Line

..... Ft. from S. Line

..... Ft. from E. Line

330 Ft. from W. Line

COMPLETE

Location.....

Rig up.....

Drilling and Remarks:

Top Line 3039
Two - 5000 gal.
acid

Pump 54588k

RECORD

Cased.....in.,ft.

Sand.....

Gas.....

Oil.....

Total Depth...3220

PRODUCTION

1st 24 hrs. Nat.....

1st 24 hrs. after shot.....

Gas.....Cu. Ft.

Dry Hole.....

Abandoned.....

Date

3/25/36 192.....

S. J. LEWIS

Scout

Russell
 Map No. 72 Sec. 32 Twp. 13 R. 14W

Well No. Box 100
Hartman & Blain Company

Contractor

SECTION PLAT

0			

330 Ft. from N. Line

_____ Ft. from S. Line

_____ Ft. from E. Line

330 Ft. from W. Line

FIRST REPORT

O W D D

Location _____

Rig up **O. W. D. D**

Drilling and Remarks:

Old TII 3220

Sil 3307-09717

Pa 8.385

5" @ 3306 WOC

RECORD

Cased _____ in., _____ ft.

Sand _____

Gas _____

Oil _____

Total Depth _____

PRODUCTION

1st 24 hrs. Nat. _____

1st 24 hrs. after shot _____

Gas _____ Cu. Ft.

Dry Hole _____

Abandoned _____

Date

AUG 12 1936

19

S. J. LEWIS

Scout

KANSAS

Map No. 72 Sec. 32 Twp. 13 R. 14W

Well No. 1 Boxberger

Hartman & Blair Company

Contractor

SECTION PLAT

0			

380 Ft. from N. Line

_____ Ft. from S. Line

_____ Ft. from E. Line

330 Ft. from W. Line

COMPLETED

Location _____

Rig up _____

Drilling and Remarks:

Sl 63306
1000 acid
Pa 8644
18 hrs.

RECORD

Cased _____ in., _____ ft.

Sand _____

Gas _____

Oil _____

Total Depth 331 1/2

PRODUCTION

1st 24 hrs. Nat. _____

1st 24 hrs. after shot _____

Gas _____ Cu. Ft.

Dry Hole _____

Abandoned _____

Date

AUG 19 1936

19

S. J. LEWIS

Scout