


Map No. Kansas, Cowley Co Sec. 32 Twp. 30 R. 5

Well No. 1 Wethers Farm  
Pattie + Banks Company

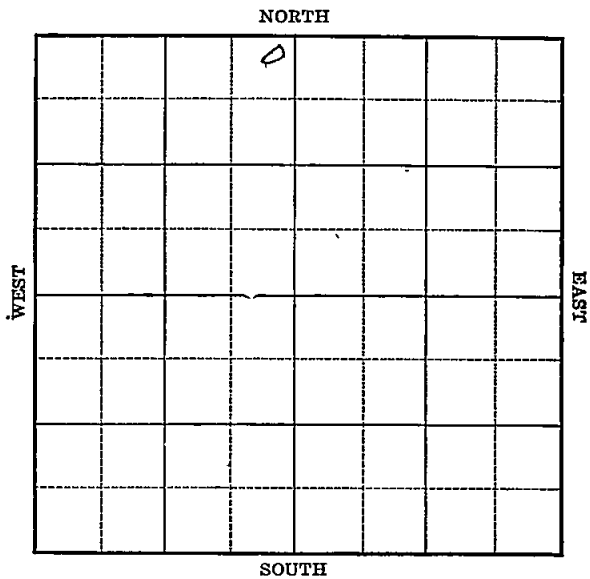

Location \_\_\_\_\_

Drilling Remarks \_\_\_\_\_  
\_\_\_\_\_  
\_\_\_\_\_  
Rig Up \_\_\_\_\_

Drilling Remarks \_\_\_\_\_  
\_\_\_\_\_  
\_\_\_\_\_  
**RECORD**

Cased \_\_\_\_\_ in. \_\_\_\_\_ ft.

Sand \_\_\_\_\_

Gas \_\_\_\_\_

Oil \_\_\_\_\_

Total Depth \_\_\_\_\_

**PRODUCTION**

1st 24 hrs. Nat. \_\_\_\_\_

1st 24 hrs. after shot \_\_\_\_\_

Gas \_\_\_\_\_ cu. ft.

Dry Hole \_\_\_\_\_

Abandoned \_\_\_\_\_

Cowley Co

Map No. Kansas Sec. 32 Twp. 30 R. 5

Well No. 1 Withers Farm


Patter & Banks Company

250 Ft. from N. Line

\_\_\_\_\_ Ft. from S. Line

250 Ft. from E. Line

\_\_\_\_\_ Ft. from W. Line

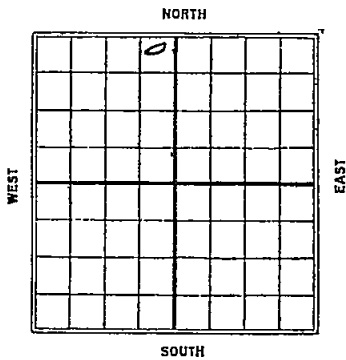

Date	REPORT
1925	
11/27	Timbers
12/3	Rq.
12/10	Rear up
12/17	_____
12/23	Dalg 250'
12/31	S. D. 400'
<del>1926</del>	
1/8	Dalg 550'
1/14	✓ 1400'
1/20	fishing 1550
1/27	_____
2/4	_____
2/10	U. R. 1600'
2/17	Dalg 1690
2/24	✓ 1875'
3/5	✓ 2241
3/10	6" 2350. Dalg 2370
3/18	Dalg - 2590
3/25	" 2715
3/31	Abandoned 2921

*Rowley Co*

*R 11*  
 Map No. **KANSAS** Sec. *32* Twp. *30* R. *5*

Well No. *1 Withers*

*PATTEE & Banco* Company

Contractor

**SECTION PLAT**

	0		

*250* Ft. from N. Line

\_\_\_\_\_ Ft. from S. Line

*250* Ft. from E. Line

\_\_\_\_\_ Ft. from W. Line

**FIRST REPORTS**

Location \_\_\_\_\_

Rig up *Sanborns.*

Drilling and Remarks:

**RECORD**

Cased \_\_\_\_\_ in., \_\_\_\_\_ ft.

Sand \_\_\_\_\_

Gas \_\_\_\_\_

Oil \_\_\_\_\_

Total Depth \_\_\_\_\_

**PRODUCTION**

1st 24 hrs. Nat. \_\_\_\_\_

1st 24 hrs. after shot \_\_\_\_\_

Gas \_\_\_\_\_ Cu. Ft.

Dry Hole \_\_\_\_\_

Abandoned \_\_\_\_\_

Date

NOV 27 1925

192

**CHAS. L. SHERWOOD**

Scout

*Rowley 30*

Map No. **KANSAS** Sec. *32* Twp. *30* R. *5*

Well No. *Witthors*  
*Patterson & Baner* Company

Contractor

**COMPLETED**

**SECTION PLAT**

*250* Ft. from N. Line  
Ft. from S. Line  
*250* Ft. from E. Line  
Ft. from W. Line


**ABANDONED**

Location

Rig up

Drilling and Remarks:

*Small show oil 2741'*  
*Dry & whd*  
*20 2921'*

**RECORD**

Cased \_\_\_\_\_ in., \_\_\_\_\_ ft.  
Sand \_\_\_\_\_  
Gas \_\_\_\_\_  
Oil \_\_\_\_\_  
Total Depth *2921'*

**PRODUCTION**

1st 24 hrs. Nat. \_\_\_\_\_  
1st 24 hrs. after shot. \_\_\_\_\_  
Gas \_\_\_\_\_ Cu. Ft.  
Dry Hole   
Abandoned

Date

MAR 31 1926

**CHAS. L. SHERWOOD**  
Scout