


Map No. _____ Sec 1 Twp 28 R 5Well No J Weaver Farm _____
Smith & Garden Company

NORTH

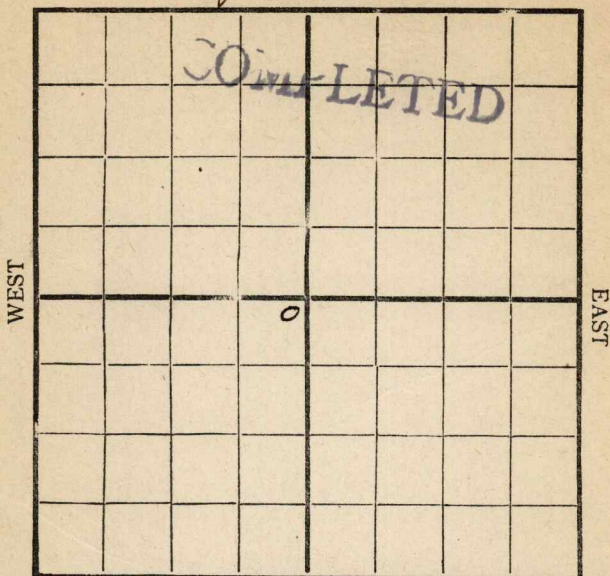

SOUTH

Location _____

Rig Up _____

Drilling Remarks:

Drilling Remarks:

RECORD

PRODUCTION

Cased _____ in _____ Ft.

1st 24 hrs. Nat _____

Sand _____

1st 24 hrs. after shot _____

Gas _____

Gas _____ Cu. Ft.

Oil _____

Dry Hole _____

Total Depth _____


Abandoned _____

Butler

Map No. Sec. *1* Twp. *28* R. *5*

Well No. *J Weaver* Farm

Smith & Gauder Company

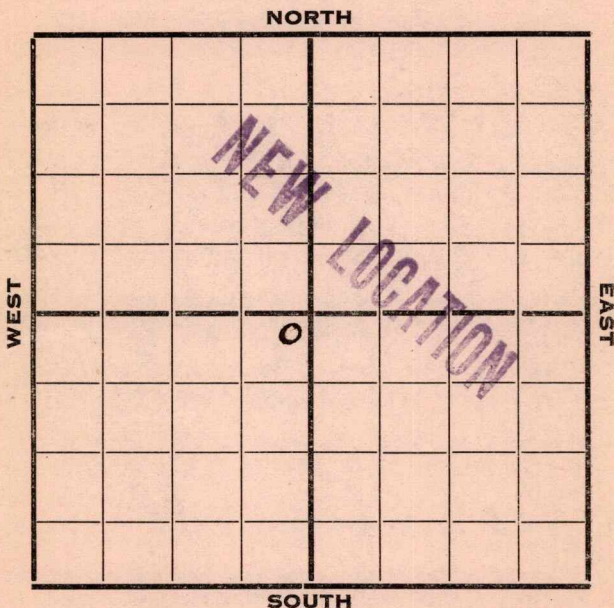

Location

Rig up

Drilling and Remarks:

*Loc.
Timber on
Ground*

RECORD

Cased in. Ft.

Sand

Gas

Oil

Total Depth

PRODUCTION

1st 24 hrs. Nat.

1st 24 hrs. after shot

Gas..... Cu. Ft.

Dry Hole


Abandoned

Date
MAR 17 1917

....., 191....., *B. T. Crocker.* Scout

Map No. _____ Sec. 1 Twp. 28 R. 5Well No. J. Weaver FarmSmith & Garden Company

NORTH

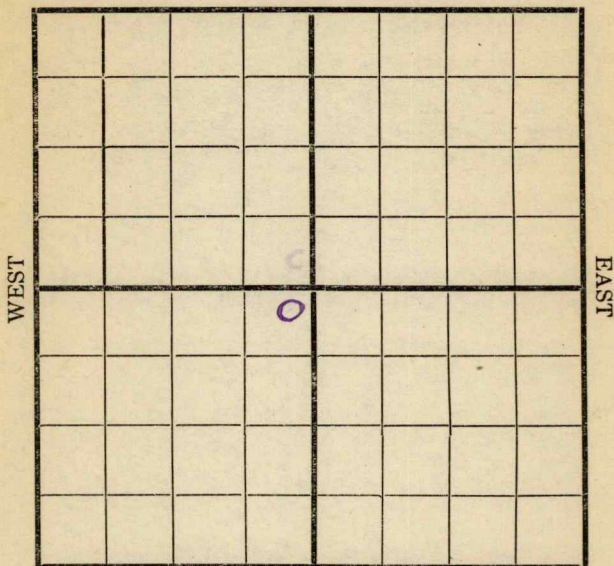

SOUTH

Location _____

Rig Up _____

Drilling and remarks

Rig up

RECORD

Cased _____ in. _____ Ft.

Sand _____

Gas _____

Oil _____

Total Depth _____

PRODUCTION

1st 24 hrs. Nat. _____

1st 24 hrs. after shot _____

Gas _____ Cu. Ft.

Dry Hole _____

Abandoned _____

Date

MAR 24 1917


E. J. Crocker

Scout

Map No. _____ Sec. _____ Twp. *28* R. *5*
 Well No. *J. Weaver* Farm _____
Smith & Gardner Company

NORTH

WEST

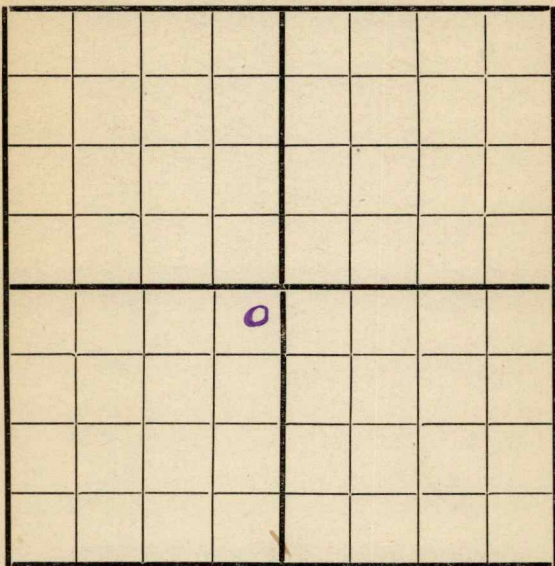

EAST

SOUTH

Location _____

Rig Up _____

Drilling and remarks

~~D-900~~
Spudding

RECORD

Cased _____ in. _____ Ft.

Sand _____

Gas _____

Oil _____

Total Depth _____

PRODUCTION

1st 24 hrs. Nat. _____

1st 24 hrs. after shot _____

Gas _____ Cu. Ft.

Dry Hole _____

Abandoned _____

Date

MAR 31 1917

G. J. Crocker
 Scout


Butler

Map No. _____ Sec. *1* Twp. *28* R. *5*

Well No. *#1* *Weaver* Farm

Smith & Garden Company

NORTH

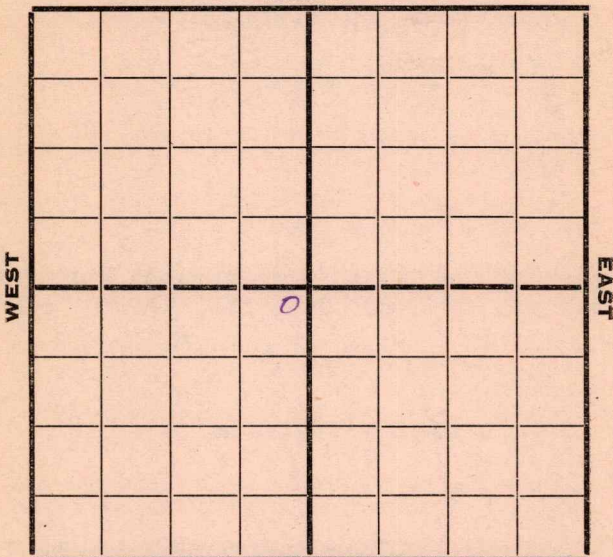

SOUTH

Location _____

Rig up _____

Drilling and Remarks:

Spudding.

RECORD

Cased _____ in. _____ Ft.

Sand _____

Gas _____

Oil _____

Total Depth _____

PRODUCTION

1st 24 hrs. Nat. _____

1st 24 hrs. after shot _____

Gas _____ Cu. Ft.

Dry Hole _____

Abandoned _____


Date

APR 7 1917

C. J. Crocker Scout

Map No. _____ Sec. _____ Twp. *28* R. *5*
 Well No. *1 J. Weaver* Farm _____
Smith & Gardner Company _____

NORTH

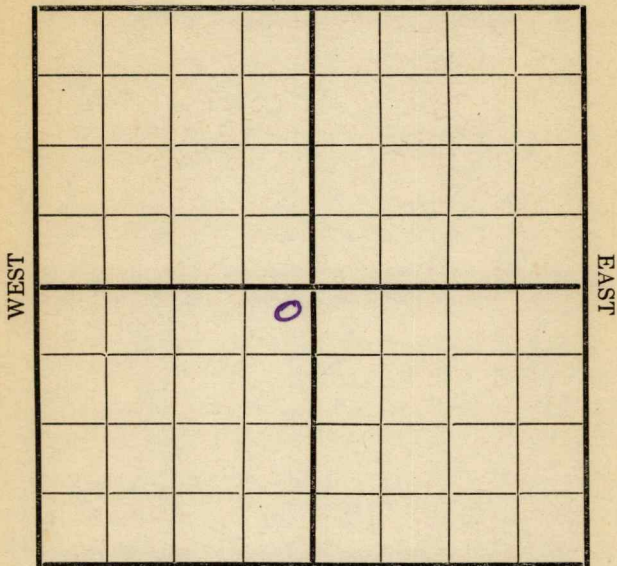

SOUTH

Location _____
 Rig Up _____
 Drilling and remarks _____

D-650'

RECORD

Cased _____ in. _____ Ft.
 Sand _____
 Gas _____
 Oil _____
 Total Depth _____

PRODUCTION

1st 24 hrs. Nat. _____
 1st 24 hrs. after shot _____
 Gas _____ Cu. Ft.
 Dry Hole _____
 Abandoned _____

Date

APR 14 191*7*

E. T. Crocker Scout

Map No. _____ Sec. 1 Twp. 28 R. 5Well No. J. Weaver FarmSmith & Gardner Company

NORTH

WEST

EAST

SOUTH

Location _____

Rig Up _____

Drilling and remarks

D 1020'

RECORD

Cased _____ in. _____ Ft.

Sand _____

Gas _____

Oil _____

Total Depth _____

PRODUCTION

1st 24 hrs. Nat. _____

First 24 hrs. after shot _____

Gas _____ Cu. Ft.

Dry Hole _____


Abandoned _____

Date

APR 2, 1917C. J. Crocker
Scout

Map No. _____ Sec. 1 Twp. 28 R. 5
 Well No. 12501 Farm _____
Smith & Garden Company

NORTH

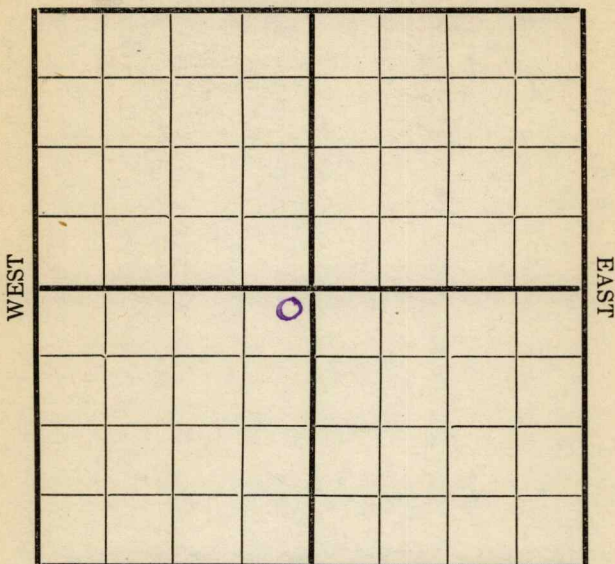

SOUTH

Location _____
 Rig Up _____
 Drilling and remarks _____

RECORD

Cased _____ in. _____ Ft.
 Sand _____
 Gas _____
 Oil _____
 Total Depth _____

PRODUCTION

1st 24 hrs. Nat. _____
 1st 24 hrs. after shot _____
 Gas _____ Cu. Ft.
 Dry Hole _____
 Abandoned _____


Date

4/28, 1917 Crocker Scout

Map No. _____ Sec. 1 Twp. 28 R. 5Well No. 1 Weaver FarmSmith & Garden Company

NORTH

WEST

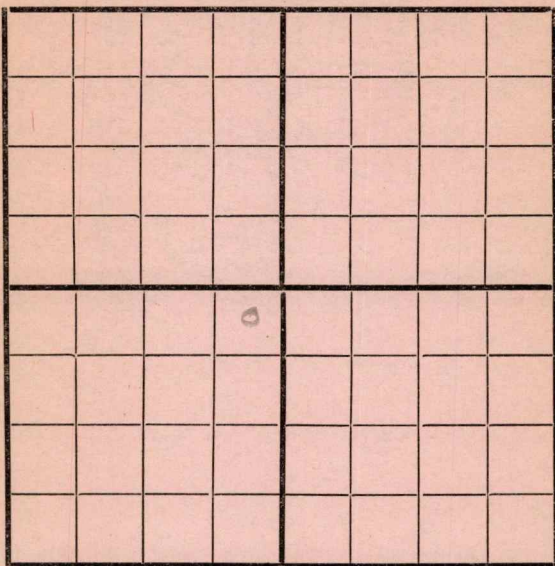

EAST

SOUTH

Location _____

Rig Up _____

Drilling and remarks

Shut Down
1410 for
Boiler
Repairs

RECORD

Cased _____ in. _____ Ft.

Sand _____

Gas _____

Oil _____

Total Depth _____

PRODUCTION

1st 24 hrs. Nat. _____

1st 24 hrs. after shot _____

Gas _____ Cu. Ft.

Dry Hole _____

Abandoned _____

Date


5/2, 1917 Candiff Scout

Map No. _____ Sec. 1 Twp. 28 R. 5
 Well No. 1 Weaver Farm
Smith & Gardner Company

NORTH

WEST

EAST

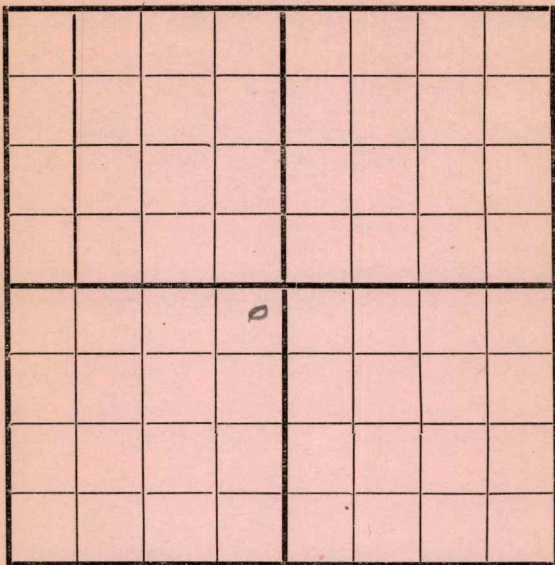

SOUTH

Location _____

Rig Up _____

Drilling and remarks

1810

RECORD

Cased _____ in. _____ Ft.

Sand _____

Gas _____

Oil _____

Total Depth _____

PRODUCTION

1st 24 hrs. Nat. _____

1st 24 hrs. after shot _____

Gas _____ Cu. Ft.

Dry Hole _____

Abandoned _____

Date


5/11, 1917 Condy Scout

Map No. _____ Sec. 1 Twp. 38 R. 5Well No. 1 Weaver FarmSmith & Gordon Company

NORTH

WEST

EAST

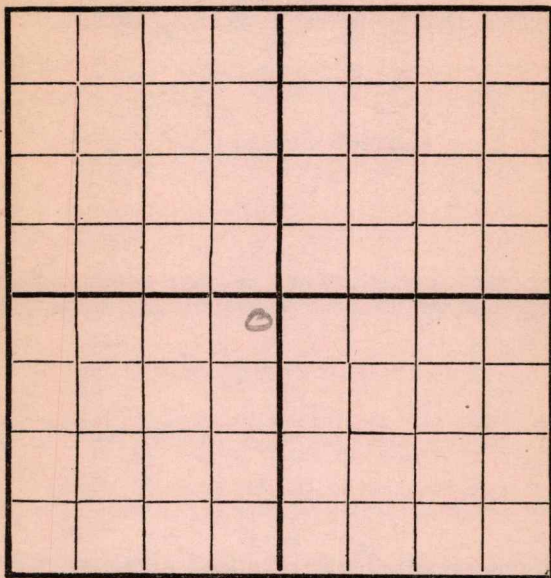

SOUTH

Location _____

Rig Up _____

Drilling and remarks

2160
Hole full
water

RECORD

Cased _____ in. _____ Ft.

Sand _____

Gas _____

Oil _____

Total Depth _____

PRODUCTION

1st 24 hrs. Nat. _____

1st 24 hrs. after shot _____

Gas _____ Cu. Ft.

Dry Hole _____


Abandoned _____

Date

5/25, 1917 Carlyle Scout

Map No. _____ Sec. 1 Twp. 28 R. 5
 Well No. 1 Weaver Farm _____
Smith & Sinden Company _____

NORTH

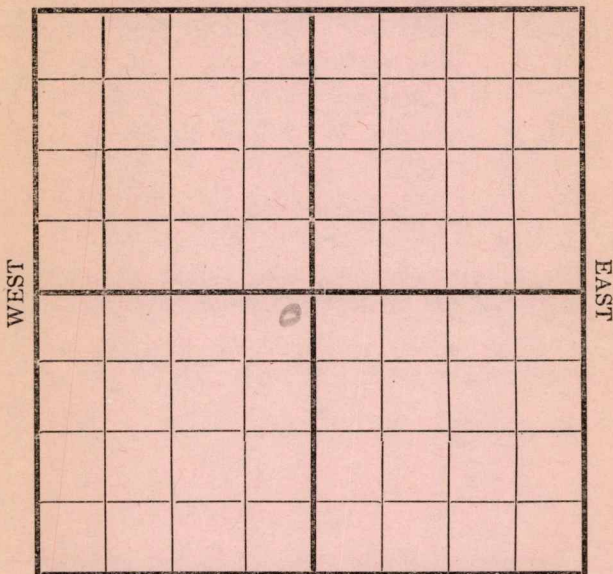

SOUTH

Location _____

Rig Up _____

Drilling and remarks

2190

RECORD

Cased _____ in. _____ Ft.

Sand _____

Gas _____

Oil _____

Total Depth _____

PRODUCTION

1st 24 hrs. Nat. _____

1st 24 hrs. after shot _____

Gas _____ Cu. Ft.

Dry Hole _____

Abandoned _____

Date


5/28 191 7 Conley Scout

Map No. 11 Sec. 1 Twp. 28 R. 5

Well No. 1 Farm

Smith & Gordon Company

NORTH

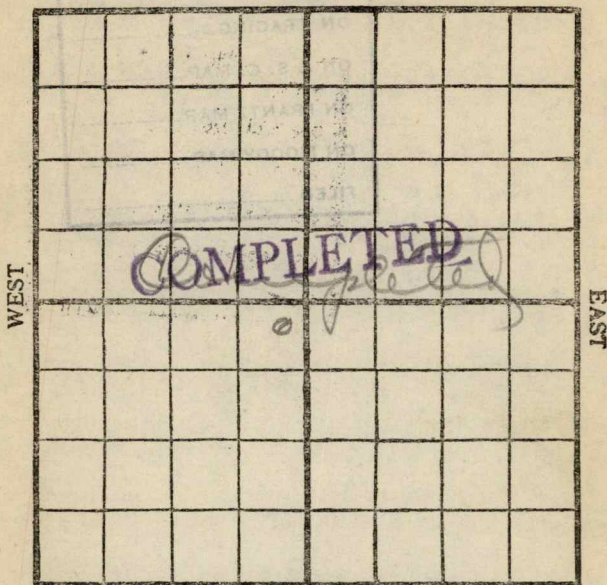

SOUTH

Location -----

Rig Up -----

Drilling and remarks

Core to 2743
 Limestone to 2745
 Break to 2752
 Best pay to 2754
 These are not steel
 line measurements
 Had good oil in
 hole

RECORD

Cased ----- in. ----- Ft.

Sand 2752-2754

Gas -----

Oil -----

Total Depth -----

PRODUCTION

1st 24 hrs. Nat. -----

1st 24 hrs. after shot -----

Gas ----- Cu. Ft.

Dry Hole -----

Abandoned -----

Date will tube & put to pump

6/8, 1917, Card Scout

Map No. _____ Sec. _____ Twp. _____ R. _____

Well No. _____ Farm _____

_____ Company _____

NORTH

WEST

EAST

Peerless

James A. Weaver

SOUTH

Location _____

Rig Up _____

Drilling and remarks _____

RECORD

Cased _____ in. _____ Ft.

Sand _____

Gas _____

Oil _____

Total Depth _____

PRODUCTION

1st 24 hrs. Nat. _____

1st 24 hrs. after shot _____

Gas _____ Cu. Ft.

Dry Hole _____

Abandoned _____

Date _____

_____, 191____. _____ Scout

Our map shows

Map No.

Well No.


lease as attached

Company

Dicket. which is right?

Chaplet on tracing
with out hangers

owner name

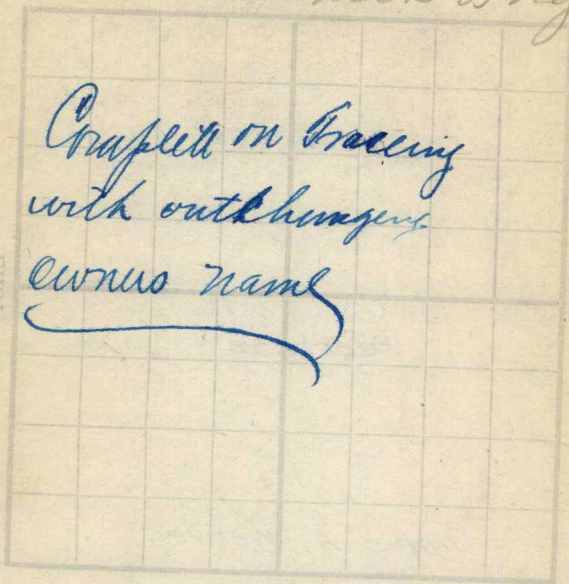

EAST

WEST

SOUTH

RECORD

Cased in Ft.
Sand
Gas
Oil
Total Depth

PRODUCTION

1st 24 hrs. Net
1st 24 hrs. after shot
Gas
Dry Hole
Abandoned

Location
Rig Up
Drilling and remarks

Date