


Map No. K Sec. 1 Twp. 28 R. 5
 Well No. Yates Farm
Deputy del Company

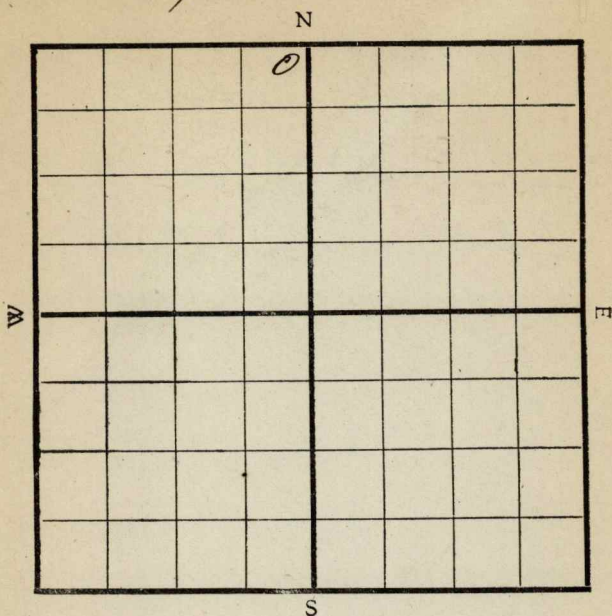

Location -----

Drilling Remarks:

RECORD

Cased ----- in. ----- ft.
 Sand -----
 Gas -----
 Oil -----
 Total Depth -----

Rig Up -----

Drilling Remarks:

PRODUCTION

1st 24 hrs. Nat. -----
 1st 24 hrs. after shot -----
 Gas ----- cu. ft.
 Dry Hole -----
 Abandoned -----

Map No. K Sec. 1 Twp. 28 R. 5Well No. 1 Yates Farm
Merley Oil Company

NORTH

200 Ft. from N. Line


Ft. from S. Line

200 Ft. from E. Line

Ft. from W. Line

WEST

EAST

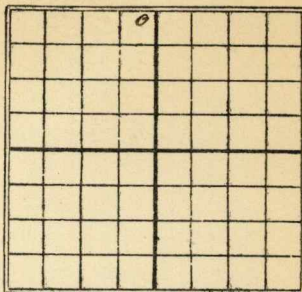

SOUTH

Date

REPORT

1/221/27Reg2/43/305/6Set 6 5/8 2430'Sand 2654-71 Shot 40 gtsPumping 100 Bbls

Map No. K11 Sec. 1 Twp. 28 R. 5Well No. 1 YatesLiberty Oil Company

Contractor

FIRST REPORT**SECTION PLAT**

200' Ft. from N. Line

Ft. from S. Line

200' Ft. from E. Line

Ft. from W. Line

Location

Rig up

Drilling and Remarks:

Rig**RECORD**

Cased _____ in., _____ ft.

Sand _____

Gas _____

Oil _____

Total Depth _____

PRODUCTION

1st 24 hrs. Nat. _____

1st 24 hrs. after shot _____

Gas _____ Cu. Ft.

Dry Hole _____

Abandoned _____

Date

JAN 27 1922191M. A. BENEAR

Scout

Map No. *K11* Sec. *1* Twp. *28* R. *5*Well No. *27* *Yates**Startup Oil* Company

Contractor

SECTION PLAT

200 Ft. from N. Line

Ft. from S. Line

200 Ft. from E. Line

Ft. from W. Line

COMPLETED

Location

Rig up

Drilling and Remarks:

Sand-2654-71
shot 4096
pumping
100 lbs.

RECORD

Cased _____ in., _____ ft.

Sand _____

Gas _____

Oil _____

Total Depth _____

PRODUCTION

1st 24 hrs. Nat. _____

1st 24 hrs. after shot _____

Gas _____ Cu. Ft.

Dry Hole _____

Abandoned _____

Date

MAY 6 1922

M. A. BENEAR

_____ 191 _____ Scout