

Well No. 2 Gales Farm

Dentby Co. Company

WEST

EAST

SOUTH

COMPLETED

Rig Up-----

Drilling Remarks:

PRODUCTION

1st 24 hrs. Nat. -----

1st 24 hrs. after shot-----

Gas -----cu. ft.

Dry Hole_____

Abandoned-----

Map No. _____ Sec. 1 Twp. 28 R. 5


Well No. #2 Yates Farm _____
Derby Oil Company _____

660 Ft. from N. Line

_____ Ft. from S. Line

200 Ft. from E. Line

_____ Ft. from W. Line

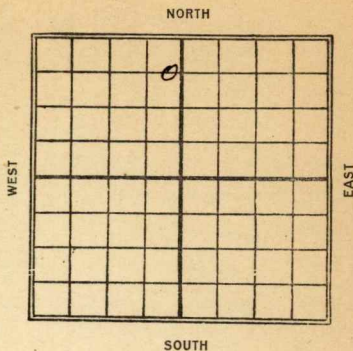

Date	REPORT
1924	
7/15	Dlg 400'
11/24	Sand 2644-70 - Shot
	30 gts. 20 Bblo.

Map No. Box 11 Sec. 1 Twp. 28 R. 5Well No. 2 YatesPerby Oil Company

Contractor

FIRST REPORT

SECTION PLAT

660 Ft. from N. Line

Ft. from S. Line

200 Ft. from E. Line

Ft. from W. Line

	o		

Location

Rig up

Drilling and Remarks:

400 to 450 ft.

RECORD

Cased _____ in., _____ ft.

Sand _____

Gas _____

Oil _____

Total Depth _____

PRODUCTION

1st 24 hrs. Nat. _____

1st 24 hrs. after shot _____

Gas _____ Cu. Ft.

Dry Hole _____

Abandoned _____

Date

JUL 15 1909

M. A. BENEAR

191

Scout

Map No. ¹¹ **KANSAS** Sec. 1 Twp. 28 R. 5Well No. 2 YatesCompany Liberty

Contractor _____

COMPLETED SECTION PLAT660 Ft. from N. Line

_____ Ft. from S. Line

200 Ft. from E. Line

_____ Ft. from W. Line

	0		

Location _____

Rig up _____

Drilling and Remarks:

shot 30 ft**RECORD**

Cased _____ in., _____ ft.

Sand _____

Gas _____

Oil 2644-70Total Depth 2670**PRODUCTION**

1st 24 hrs. Nat. _____

1st 24 hrs. after shot 20

Gas _____ Cu. Ft.

Dry Hole _____

Abandoned _____

Date

NOV 24 1922

M. A. BENEAR

191

Scout